IREDELL COUNTY HEALTH DEPARTMENT

STATESVILLE 704-878-5305 MOORESVILLE 704-664-5281

IMPROVEMENT PERMIT / AUTHORIZATION TO CONSTRUCT / OPERATION PERMIT / EXISTING SYSTEM INSPECTION

DATE 11-20-98

PERMIT# 97778 PIN# 4784 10 4855

OWNER OR CONTRACTOR Beth Brown PHONE: Business Home 871 1805

ADDRESS 269 River Hill Rd

LOCATION 64E TR Barn oak TR Elmwood before 4th crwk on left. .3

SUBDIVISION BLOCK / SECTION LOT 3 LOT AREA 16 acres SITE CLASS PS DESIGN FLOW 360 L.T.A.R.

Septic Tank: 1000 Gallons; STB 160 Date 3-30-01

Pump Tank: Gallons; PT Date

Pump Make: Model Serial No.

Nitrification Field: No. Fields 1 Square Feet 1200 Linear Feet 400

No. Lines 3 Trench Width 36" Max Trench Bottom Depth 34" Gravel Depth 12"

[x] New System [ ] Repair System Type: [ ] I [x] II, III, IV, V, VI

System Description: Conv. Drainfield

Repair System Description:

Maintenance Agreement Required: [ ] Yes [x] No

[x] House/Mod. Home No. Bedrooms 3

[ ] Mobile Home No. Bathrooms 2½

[ ] Business No. Employees

[ ] Other


[ ] Slab [ ] Crawl Space [ ] Basement w/plumbing [ ] Basement wo/plumbing

Water Supply: [x] Individual [ ] Public [ ] Community


Comments:/Conditions: 400' ~

Comments:/Conditions: 2 ABEC FILTER + MARKER

INITIAL SITE SKETCH

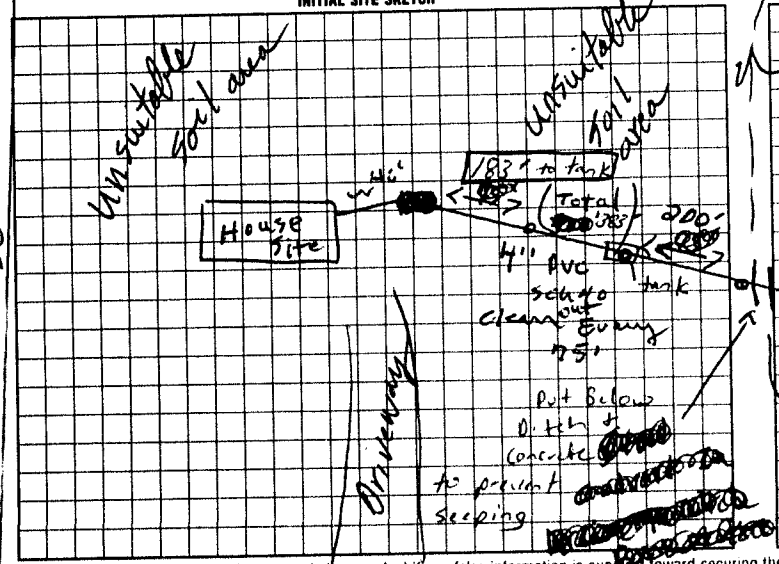

AS BUILT SKETCH

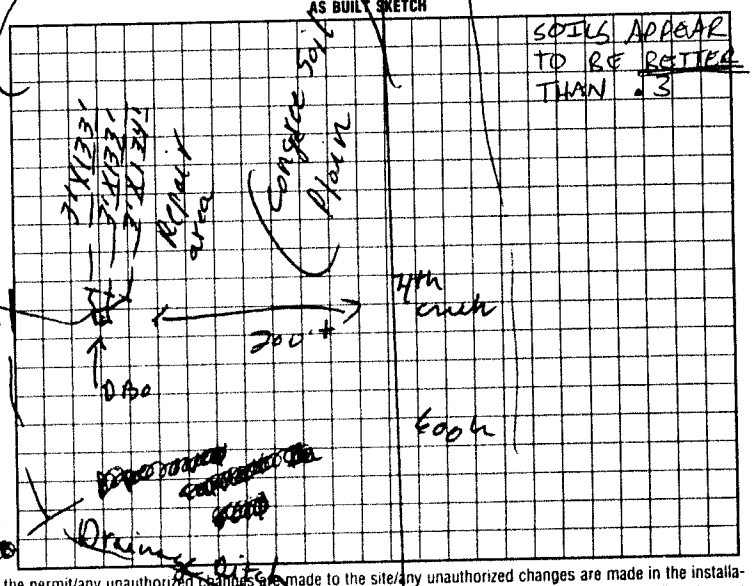

SOILS APPEAR TO BE BETTER THAN .3

I understand that this permit can be suspended or revoked if any false information is supplied toward securing the permit/any unauthorized changes are made to the site/any unauthorized changes are made in the installation of the system. Improvement Permit with plat valid without expiration. Improvement Permit with site plan valid for sixty months. Authorization to Construct is valid for a period equal to that of Improvement Permit – not to exceed sixty months.

Signed: X Beth Brown date 11/20/98 Installed by: BARRY SIGMON

Improvement Permit by: P.C. Moore date 11-20-98 Operation Permit by: Tim Cole REHS date 5-11-01

Authorization to Construct by: P.C. Moore date 11-20-98 Existing System Inspection by: date

HEALTH DEPT. COPY: WHITE INSPECTION COPY (FINAL): GREEN OWNER COPY (FINAL): YELLOW INSPECTION COPY (INITIAL): PINK OWNER COPY (INITIAL): GOLD

Elmwood Rd