IREDELL COUNTY HEALTH DEPARTMENT

Statesville Office (704) 878-5305 Mooresville Office (704) 660-3625 PERMIT # 218091

IMPROVEMENT PERMIT / AUTHORIZATION TO CONSTRUCT / OPERATION PERMIT / EXISTING SYSTEM

PIN # 4783123284

APPLICANT: Mid-State Metals APPLICANT ADDRESS: 2415 Rory Rd. Cleveland

SITE ADDRESS: 3301 Salisbury Hwy PHONE: 704-278-3050 ALT. PHONE: 704-872-3148

SITE DIRECTIONS: Hwy 70 E, Property on left just before county line

SUBDIVISION: N/A SECTION: N/A LOT # N/A LOT AREA: 11.58 acres DESIGN FLOW: Existing L.T.A.R.: Existing

Septic Tank	Existing	(gal)	STB		Date				
Pump Tank		(gal)	PT		Date				
Pump Make			Model		Serial #				
# Nitrification Fields	Ex		# Lines	Ex	Linear Ft:	Ex			
Trench Width	Ex		Max. Trench Bottom Depth	Ex	Gravel Depth	Ex			

☐ New System ☐ Repair ☐ Expansion System Type: I (II) III IV V VI

System Description: Existing

Repair System Description:

Maintenance Agreement Required: ☐ YES ☑ NO ☐ GRAVITY ☐ PRESSURE

☐ Residence ☐ Business ☐ Other ☑ Slab ☐ Crawl Space ☐ Basement w/plumbing ☐ Basement w/o plumbing


No. Bedrooms: No. Persons: No. Employees: Ex

Water Supply: ☑ Private ☐ Public ☐ Community


Comments / Conditions:

- Maintain a minimum of 5' between proposed shed foundation & all components of septic tank system.

INITIAL SITE SKETCH

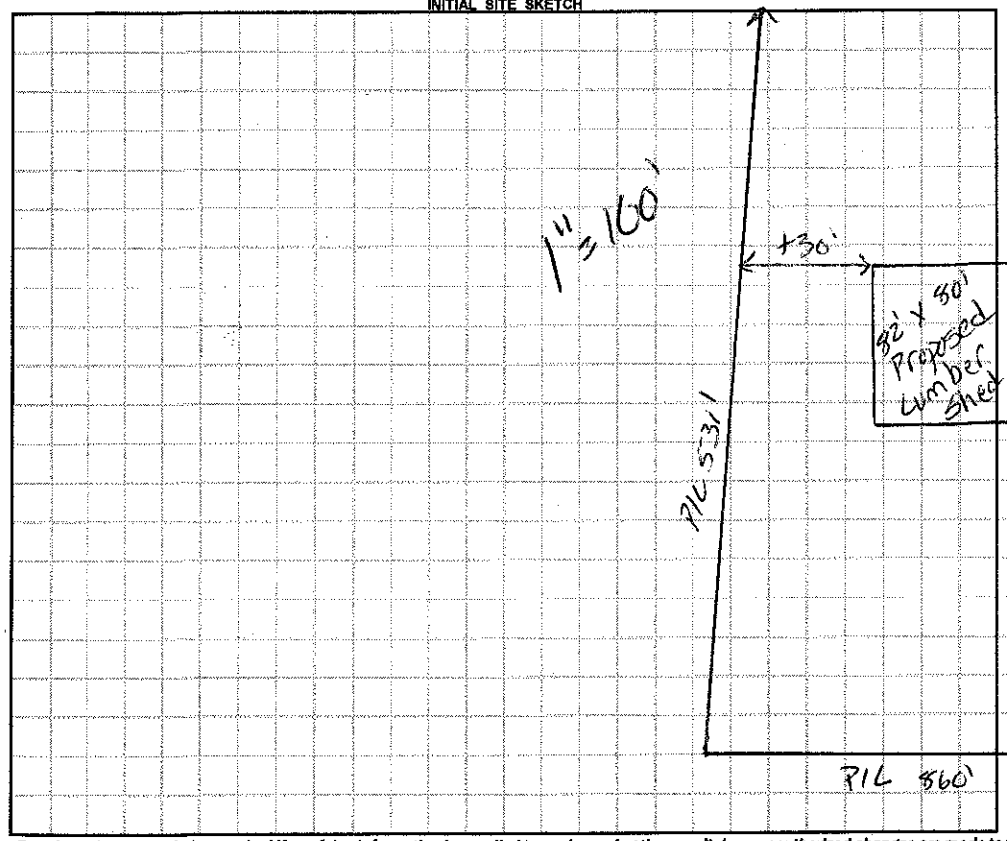

AS BUILT SKETCH

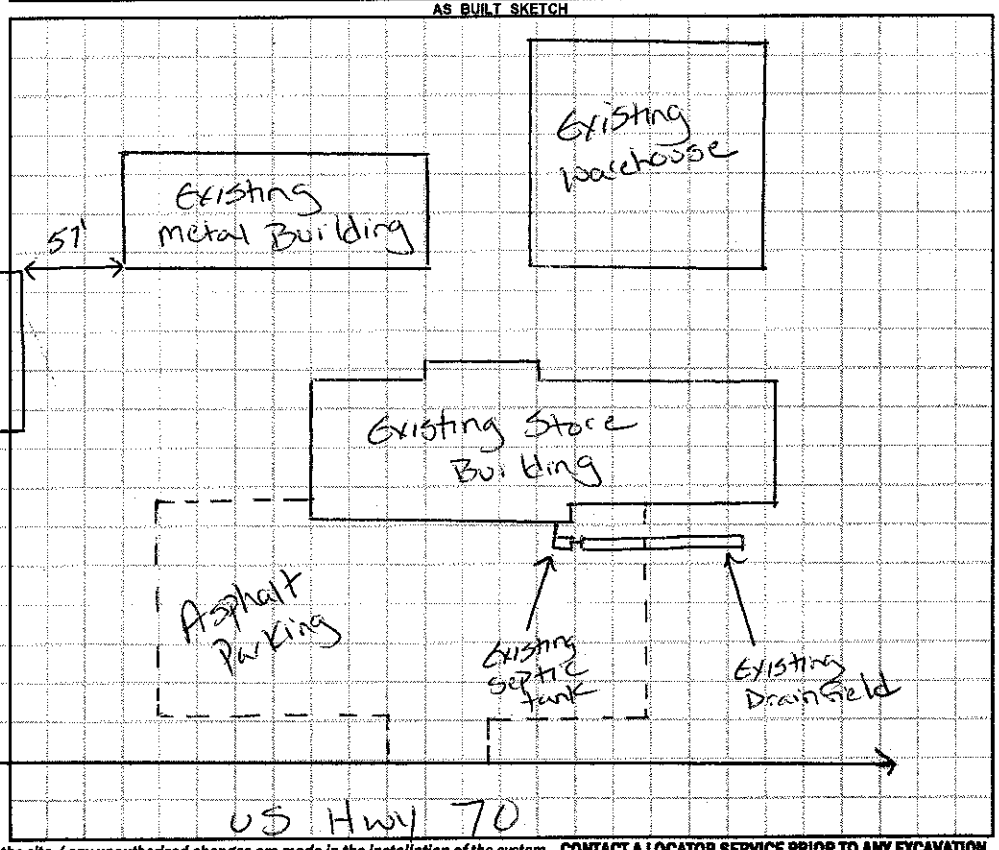

Permit can be suspended or revoked if any false information is supplied toward securing the permit / any unauthorized changes are made to the site / any unauthorized changes are made in the installation of the system. **CONTACT A LOCATOR SERVICE PRIOR TO ANY EXCAVATION**

☐ **IMPROVEMENT PERMIT** *with plat valid without expiration.* ☐ **IMPROVEMENT PERMIT** *with site plan valid for 60 mos.* ☐ **AUTHORIZATION TO CONSTRUCT** *valid for period equal to IMPROVEMENT PERMIT--not to exceed 60 mo.*

Owner / Applicant Signature: Date: 5/31/16 Installed by:

IMPROVEMENT PERMIT by: Date: OPERATION PERMIT by: Date:

AUTHORIZATION TO CONSTRUCT by: Date: Existing System Inspected by: Justin Donaldson Date: 5-20-16

Health Dept. Copy - WHITE Applicant (Final Approval) - YELLOW Applicant (Conditional Approval) - PINK