IREDELL COUNTY HEALTH DEPARTMENT

Statesville Office (704) 878-5305 Mooresville Office (704) 660-3625 PERMIT # 207970

IMPROVEMENT PERMIT / AUTHORIZATION TO CONSTRUCT / OPERATION PERMIT / EXISTING SYSTEM

PIN # 4783123784

APPLICANT: Sammy Deal Construction APPLICANT ADDRESS: 449 Fanjoy Rd.

SITE ADDRESS: 3301 Salisbury Hwy PHONE: 704-500-1783 ALT. PHONE: N/A

SITE DIRECTIONS: Hwy 70 E, Property on Left just before county line.

SUBDIVISION: N/A SECTION: N/A LOT # N/A LOT AREA: 11.88 acres DESIGN FLOW: Existing L.T.A.R.: Existing

Septic Tank Existing (gal) STB Date

Pump Tank (gal) PT Date

Pump Make Model Serial #

Nitrification Fields Ex # Lines Ex Linear Ft: Ex

Trench Width Ex Max. Trench Bottom Depth Ex Gravel Depth Ex

☐ New System ☐ Repair ☐ Expansion System Type: I (II) III IV V VI

System Description: Conv. bed

Repair System Description:

Maintenance Agreement Required: ☐ YES ☑ NO

☑ GRAVITY ☐ PRESSURE

☐ Residence ☑ Business ☐ Other ☑ Slab ☐ Basement w/plumbing

No. Bedrooms No. Persons Ex No. Employees ☐ Crawl Space


☐ Basement w/o plumbing

Water Supply: ☑ Private ☐ Public ☐ Community


Comments / Conditions:

- Maintain a minimum of 5' between building foundation & all components of septic tank system.

INITIAL SITE SKETCH

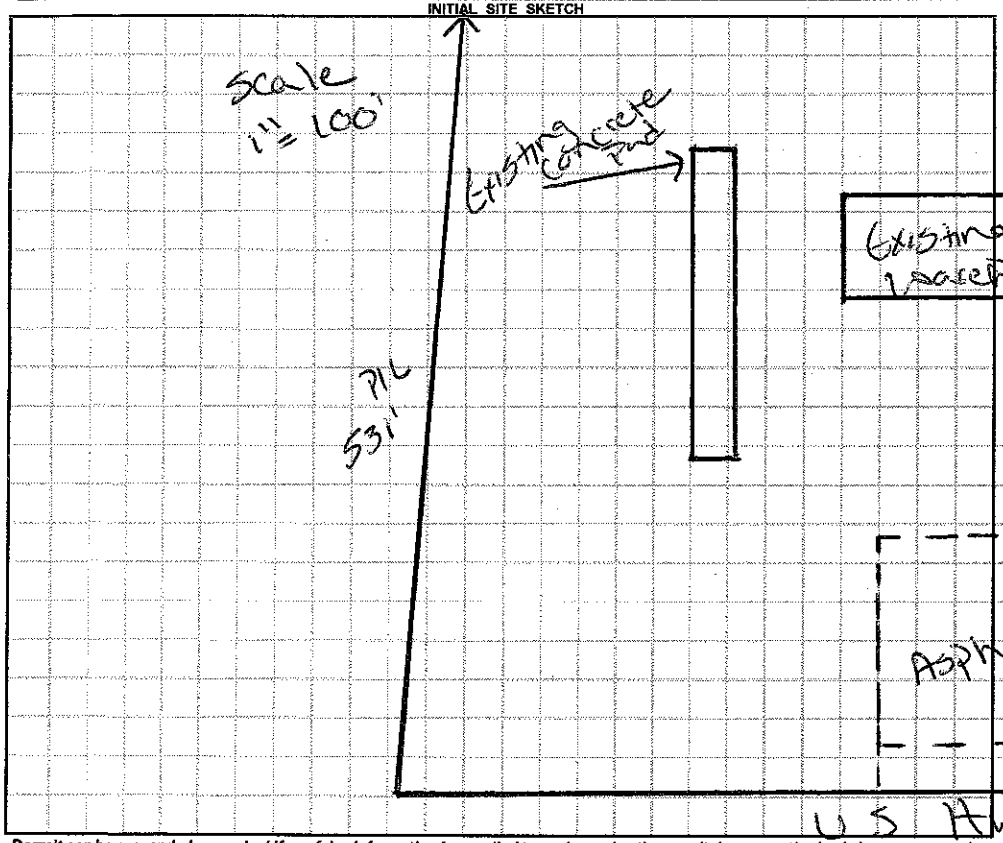

AS BUILT SKETCH

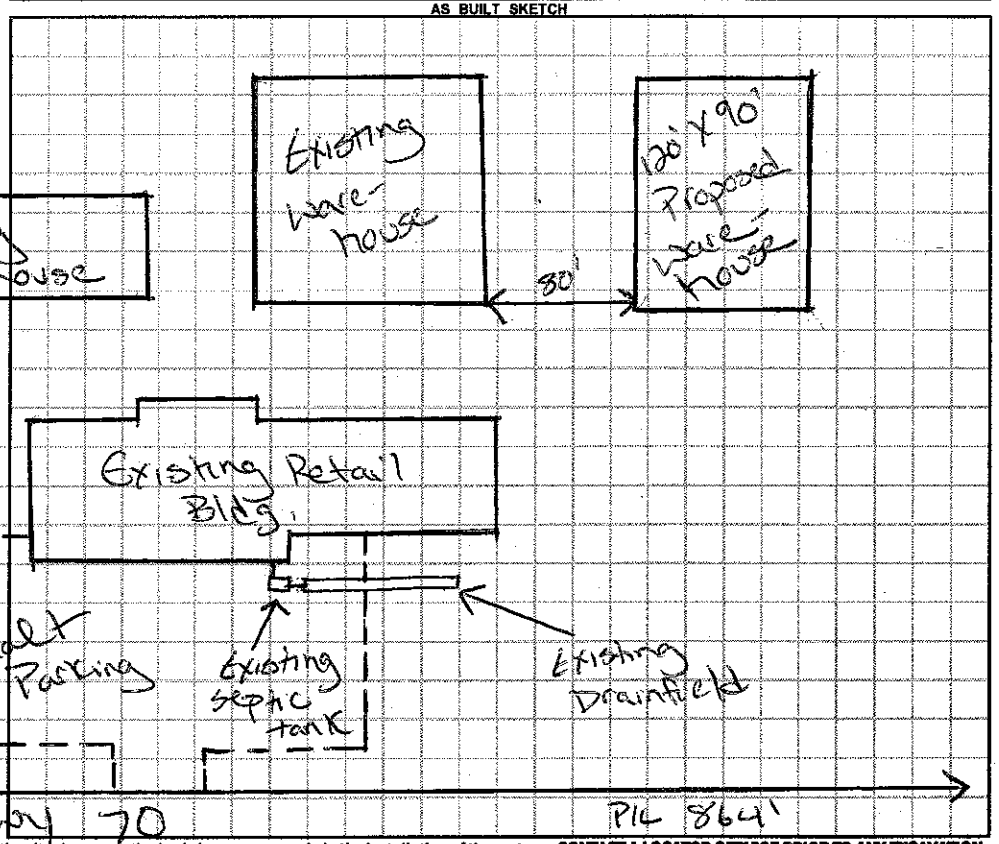

Permit can be suspended or revoked if any false information is supplied toward securing the permit / any unauthorized changes are made to the site / any unauthorized changes are made in the installation of the system. **CONTACT A LOCATOR SERVICE PRIOR TO ANY EXCAVATION**

☐ **IMPROVEMENT PERMIT** *with plat valid without expiration.* ☐ **IMPROVEMENT PERMIT** *with site plan valid for 60 mos.* ☐ **AUTHORIZATION TO CONSTRUCT** *valid for period equal to IMPROVEMENT PERMIT--not to exceed 60 mo.*

Owner / Applicant Signature: Date: 2-3-15 Installed by:

IMPROVEMENT PERMIT by: Date: OPERATION PERMIT by: Date:

AUTHORIZATION TO CONSTRUCT by: Date: Existing System Inspected by: Date: 2-2-15

Health Dept. Copy - WHITE Applicant (Final Approval) - YELLOW Applicant (Conditional Approval) - PINK