IREDELL COUNTY HEALTH DEPARTMENT

Statesville Phone TR 3-7271 Mooresville Phone No. 664-5281

PERMIT TO INSTALL SEPTIC TANK

Permit No. 369 Permit Date 7-11 1973

Owner RALPH Brown Address Rt. 1 Statesville,

Installed By Sam Stewart Address Troutman, NC


Location of Property Elmwood - LEFT on Rd # 2308 - Go 1 MILE on Rt 300 Ft. OFF of Rd.

Tank		Capacity		Length of Lines		Fixtures	
Block	( )	1000	(✓)	225'	(✓)	No. of Baths	(✓)
Precast	(✓)	1250	( )	250'	( )	Dishwasher	( )
		1500	( )	Other		Garbage Grdr.	( )
		Other				Other	

NOTIFY HEALTH DEPARTMENT AT LEAST EIGHT HOURS BEFORE TANK IS TO BE INSPECTED.

Final Inspection 7-11 1973 Approved (✓) Disapproved ( )

Remarks

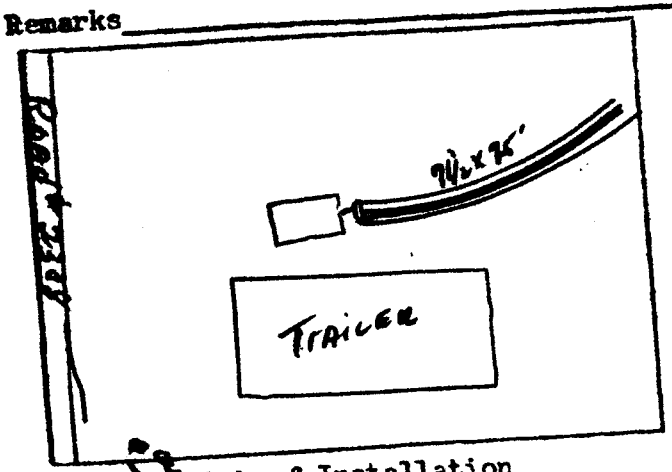

Sketch of Installation

Sanitarian