IREDELL COUNTY HEALTH DEPARTMENT

STATESVILLE 704-878-5305 MOORESVILLE 704-664-5281

IMPROVEMENT PERMIT / CERTIFICATE OF COMPLETION / OPERATION PERMIT / EXISTING SYSTEM INSPECTION

PROPERTY DESCRIPTION NO. 21610 DATE 7-18-95 TAX MAP NO. 5P-A-93 Watershed: ☐ Yes ☐ No

OWNER OR CONTRACTOR Scott Carter PHONE: Business Home 871-8313

ADDRESS 210 Family Tree Dr.

LOCATION 70E 7th Elmwood Rd approx 1mi TR Family Tree Dr at end

SUBDIVISION BLOCK / SECTION LOT LOT AREA SITE CLASS. DESIGN FLOW 360 L.T.A.R.

Septic Tank: Gallons; STB Date

Pump Tank: Gallons; PT Date

Pump Make: Model Serial No.

Nitrification Field: No Fields Square Feet Linear Feet

No Lines Trench Width Max Trench Bottom Depth Gravel Depth

☐ New System ☐ Repair System Type: I, II, III, IV, V, VI

System Description:

Repair System Description:

Maintenance Agreement Required: ☐ Yes ☐ No

☑ House/Mod. Home No. Bedrooms 3

☐ Mobile Home No. Bathrooms 2

☐ Business No. Employees

☐ Other


☐ Slab ☐ Crawl Space ☐ Basement w/plumbing ☐ Basement wo/plumbing

Water Supply:
☑ Individual
☐ Community
☐ Public


Comments:

Comments:

INITIAL SITE SKETCH

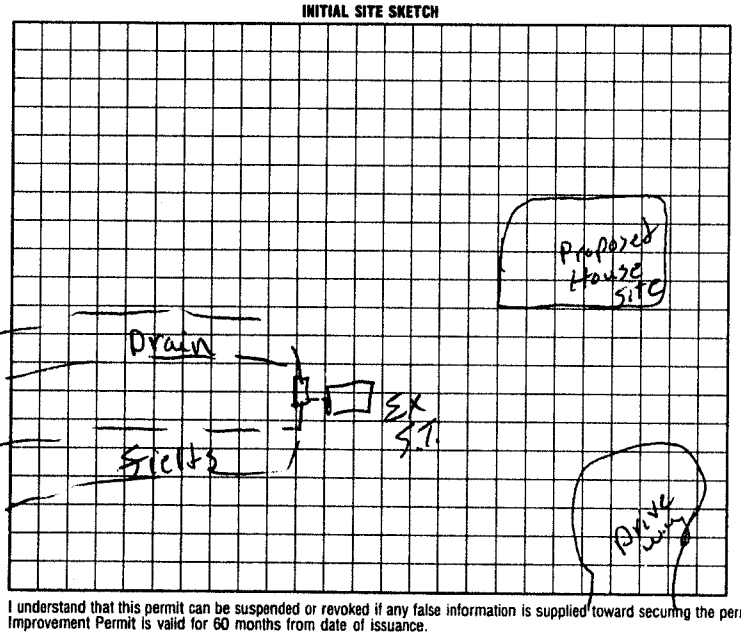

AS BUILT SKETCH

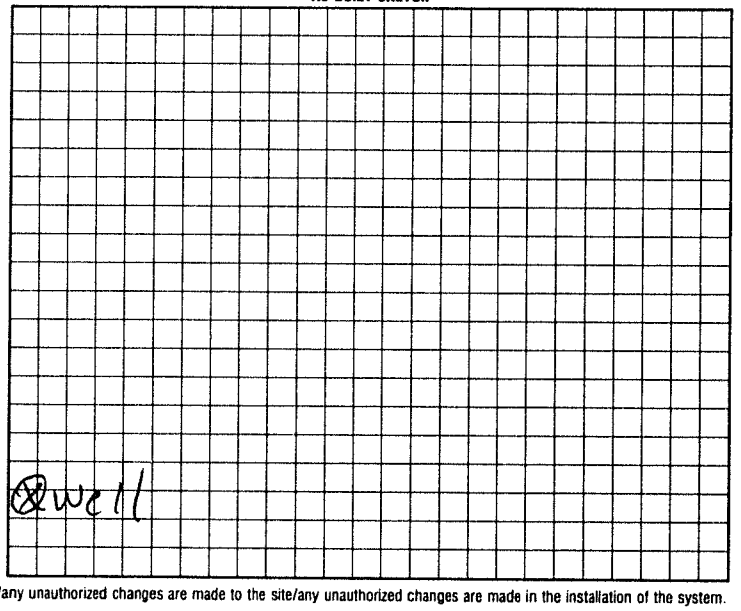

I understand that this permit can be suspended or revoked if any false information is supplied toward securing the permit/any unauthorized changes are made to the site/any unauthorized changes are made in the installation of the system. Improvement Permit is valid for 60 months from date of issuance.

Signed:

Improvement Permit by: date

Existing System Inspection by: R. C. Moore date 7-18-95

Installed by:

Certificate of Completion by: date

Operation Permit by: date

HEALTH DEPT. COPY: WHITE INSPECTION COPY (FINAL): GREEN OWNER COPY (FINAL): YELLOW INSPECTION COPY (INITIAL): PINK OWNER COPY (INITIAL): GOLD