ICHD - ENVIRONMENTAL HEALTH DIVISION

Statesville Office (704) 878-5305 Mooresville Office (704) 660-3625 PERMIT # AP-318449

SEPTIC: IMPROVEMENT PERMIT / AUTHORIZATION TO CONSTRUCT / OPERATION PERMIT / EXISTING SYSTEM

PIN # 4784-02-8329

APPLICANT/OWNER: FREDERICK JETTER APPLICANT ADDRESS: 668 LONGVIEW ROAD, STATESVILLE, N.C. 28625

SITE ADDRESS: 668 LONGVIEW ROAD, STATESVILLE, N.C 28625 PHONE: 704-880-5736 ALT. PHONE —

SITE DIRECTIONS: (E) ON 70, (L) ON SALISBURY HIGHWAY, (R) ON ELMWOOD, (R) ON LONGVIEW, LOT ON (L) SAP CONTROLLED: ☐ YES ☐ NO EXT


SUBDIVISION: — SECTION: — LOT # — LOT AREA: 7.27 AC DESIGN FLOW: EXT L.T.A.R.: EXT

Septic Tank	1000	(gal)	STB	STOAE-7160	Date	5/18/21	☐ New System	☑ Repair	☐ Expansion	System Type: I (II) III IV V VI	
Pump Tank	—	(gal)	PT	—	Date	—	System Description:			EXT	
Pump Make	—	Model		—	Serial #	—	Repair System Description:			TANK REPLACEMENT	
# Nitrification Fields	EXT	# Lines		EXT	Linear Ft:	EXT	Maintenance Agreement Required:		☐ YES	☑ NO	
Trench Width	EXT	Trench Bottom Depth(Low side)		EXT	Gravel Depth	EXT	☑ GRAVITY		☐ PRESSURE		

☑ Residence	No. Bedrooms	EXT	**Water Supply**
☐ Business	No. Persons	EXT	☑ Private EXT
☐ Other	No. Employees	—	☐ Public
☐ Slab	☐ Crawl Space		☐ Community
☑ Basement w/plumbing			☐ Basement w/o plumbing

Comments / Conditions: PUMP, CRUSH, AND FILL EXISTING SEPTIC TANK, MAINTAIN SOFT FROM ALL WELLS, INSPECT AND REPLACE DISTRIBUTION DEVICES AS NEEDED, SYSTEM APPEARED TO BE FUNCTIONING AT TIME OF INSPECTION

INITIAL SITE SKETCH

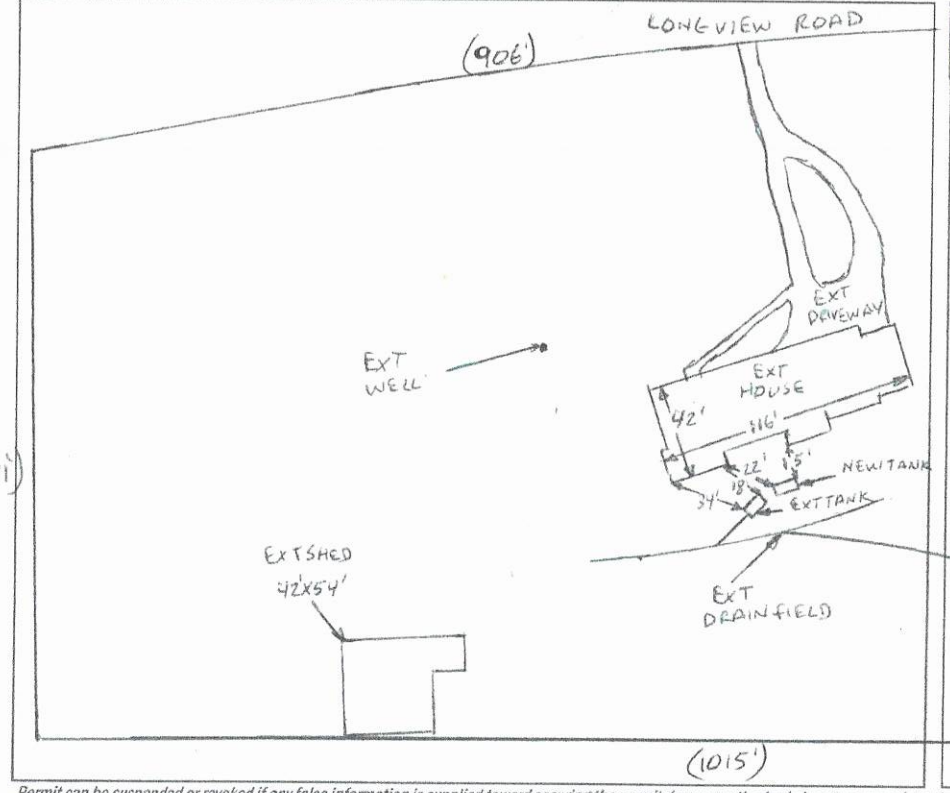


AS BUILT SKETCH

FOR SEPTIC FINAL INSPECTION CALL: 704-664-3703 between 8am-9am the day the inspection is needed. Be sure to speak with an inspector to confirm your time.

1 IN = 80 FT

EXT = EXISTING

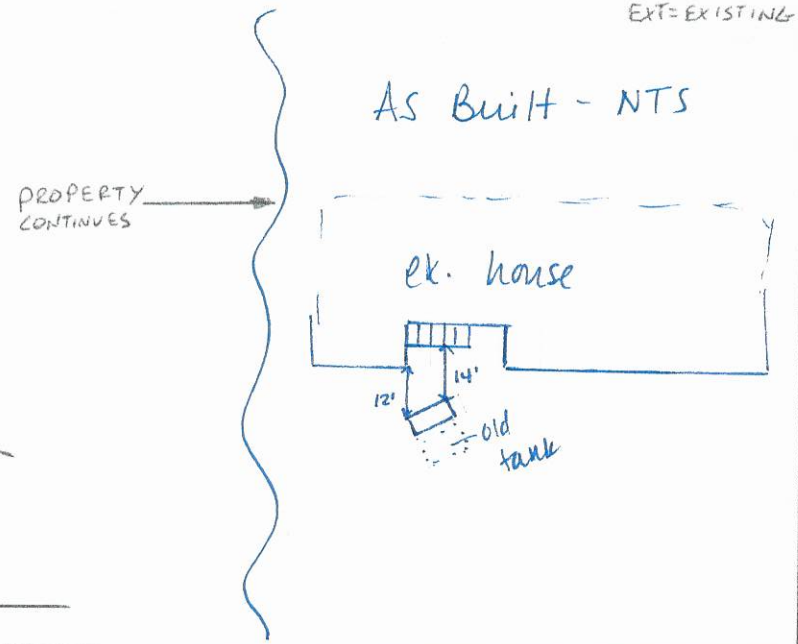

Permit can be suspended or revoked if any false information is supplied toward securing the permit / any unauthorized changes are made to the site / any unauthorized changes are made in the installation of the system. **CONTACT A LOCATOR SERVICE PRIOR TO ANY EXCAVATION**

☐ **IMPROVEMENT PERMIT** *with plat valid without expiration.* ☑ **IMPROVEMENT PERMIT** *with site plan valid for 60 mos.* ☑ **AUTHORIZATION TO CONSTRUCT** *valid for period equal to IMPROVEMENT PERMIT--not to exceed 60 mo.*

Owner / Applicant Signature: Frederick W. Jetter Date: 7-1-21 Installed by: Lentz Wastewater

IMPROVEMENT PERMIT by: Burt Conlee Date: 6-30-2021 OPERATION PERMIT by: D. Weberg Date: 7/9/21

AUTHORIZATION TO CONSTRUCT by: Burt Conlee Date: 6-30-2021 Existing System Inspected by: Date:

FOR SEPTIC FINAL INSPECTION: CALL 704-664-3703 between 8am-9am the day the inspection is needed.

RECEIVED JUN 3 - 2021

APPLICATION MUST BE FILLED OUT COMPLETELY & BE LEGIBLE OR IT WILL NOT BE PROCESSED

Repair Evaluation-No Chg

Iredell County Health Department – Environmental Health Division

PAGE 1: *APPLICATION FORM*

AP- 318449

Application For:
( ) New Well Permit ( ) Well Repair Permit ( ) Well Abandonment
( ) Septic Improvement Permit ( ) Authorization to Construct ( ) Existing System Inspection (✓) Septic System Repair

THE ABOVE PERMIT DOCUMENTS WILL BECOME INVALID IF INFORMATION PROVIDED ON THIS APPLICATION IS FALSIFIED OR CHANGED, OR IF THE SITE IS ALTERED. THE IMPROVEMENT PERMIT IS VALID FOR EITHER 60 MONTHS OR WITHOUT EXPIRATION DEPENDING UPON DOCUMENTATION SUBMITTED. APPLICATION WITH SITE PLAN 60 MONTHS, APPLICATION WITH COMPLETE, SCALED PLAT WITHOUT EXPIRATION. SEE 15A NCAC 18A .1937(f) FOR DETAILS.

Page 2: *Site Plan Worksheet* form MUST accompany this application

The following optional attachments may also be submitted: ( ) Survey Plat, scaled no more than 1 inch = 60 feet
Place an (X) beside whichever is submitted if applicable ( ) Custom Site Plan, scaled no more than 1 inch = 60 feet

Applicant Information: (PRINT CLEARLY)

Applicant Name: Frederick Jetter **Address:** 668 Longview Rd **Zip:** 28625
Applicant Email: fredjetter@gmail.com **Phone:** 704 880 5736 **Alt. Phone:**
Owner Name: Frederick Jetter **Address:** 668 Longview Rd **Zip:**
Owner Email: fredjetter@gmail.com **Phone:** 704 880 5736 **Alt. Phone:**

Property Information:

Street Address: 668 Longview Rd Statesville, N.C 28625

Subdivision Name: **Section/Phase:** **Lot Number:**

Driving Directions:

Site Development Information: *(check or complete ALL that apply*

( ) New Single Family Residence
( ) New Multi-Family Residence
( ) Accessory Building
( ) Bedroom(s) Addition
(✓) Repair to failing septic system ✓ Tank ___ Drain lines Describe Problem: Caved in - 2 holes in top

Maximum Number of Bedrooms: 3
Maximum Number of Occupants: 2
( ) Swimming Pool
( ) Other Addition/Structure:

CHECK FOUNDATION TYPE
( ) Crawl Space Foundation
( ) Concrete Slab Foundation
(✓) Basement with Plumbing
( ) Basement without Plumbing

Non-Residential Site Development: Type of Business:
Square Footage of Building: Max. Number of Employees: Max. Number of Seats/Beds/Other:

Water Supply: ( ) Replacement Well – Reason:
( ) Multi-connection Well Number of Houses: Number of Persons:
( ) New Well ( ) Existing Well ( ) Community Well ( ) City Water ( ) Other Public Water

Desired Septic System Type: *(you may rank in order of preference)* Year existing system installed:
( ) No Preference ( ) Alternative ( ) Conventional ( ) Innovative ( ) Modified Conventional ( ) Other:

Please answer the following to the best of your ability:
( ) Yes (✓) No Does the site contain any jurisdictional wetlands?
( ) Yes (✓) No Is any non-domestic sewage (i.e. industrial) to be generated?
( ) Yes (✓) No Is the site subject to approval by any other public agency?

I have read this application and certify that the information provided herein is true, complete, and correct. Authorized county and state officials are granted right of entry to conduct necessary inspections to determine compliance with applicable laws and rules. I understand that I am solely responsible for the proper identification and labeling of all property lines and corners and making the site accessible so that a complete site evaluation can be performed.

Signature: _____ 6-3-2021
Property owner or owner's legal representative signature (SIGNATURE REQUIRED) DATE

IREDELL COUNTY DEPARTMENT OF ENVIRONMENTAL HEALTH

DOCUMENTATION TO AUTHORIZE AN OWNER'S LEGAL REPRESENTATIVE

(Check and sign only ONE of the options below)

☑ **1. * APPLICANT AND OWNER ARE THE SAME. *** (*Sign here*) _____

Applications for permits require the "signature of the owner or owner's legal representative" (15A NCAC 18A .1937). If the owner does not sign the application himself or herself, they can submit any one of the following documents to designate their legal representative: *Power of Attorney; Real Estate Contract; Estate executor; Bankruptcy trustee; Court ordered guardianship*
In the absence of the above documentation, the property owner may provide the local health department with documentation that designates a legal representative. A property owner may:
Complete this form to document his or her legal representative, or provide his or her own form that contains the information in this form. If there are multiple property owners, then all property owners must sign the form that designates a legal representative.
By signing a form that designates a legal representative for purposes of 15A NCAC 18A .1937, the property owner authorizes that representative to act on their behalf in matters pertaining to the application and permitting process, including signing or receiving any application, document or permit. The owner retains full responsibility to meet all permit conditions specified by the local health department.

☐ **2.** I, _____, am the legal owner(s) of the property located at _____, identified as PIN (Parcel Identification Number)_____, located in Iredell County, North Carolina.

I do hereby authorize (**print legal representative/company name**) _____, _____, to act as an agent on my behalf in applying for/signing/obtaining any of the documents described below.

- Application for Improvement Permit (IP) / Authorization to Construct (AC)
- Improvement Permit (IP) / Authorization to Construct (AC)
- Application for soil-site evaluation (new/repair)
- Application/permit for private drinking water well/well abandonment
- Application for Compliance Inspection

I agree to abide by all decisions and/or conditions between the legal representative acting on my behalf and the Iredell County Department of Public Health, Environmental Health Division.


_____ _____
Signature of Owner(s) Date

Mooresville - Environmental Health
Fax: 704-662-3239
610 E. Center Avenue, Mooresville, NC 28115

Statesville - Environmental Health
ronda.hart@co.iredell.nc.us
Fax: 704-871-3483
349 N. Center Street, Statesville, NC 28677

IREDELL COUNTY HEALTH DEPARTMENT
ENVIRONMENTAL HEALTH DIVISION
PAGE 2: *SITE PLAN WORKSHEET*

SEE THE "SAMPLE SITE PLAN" BELOW. *INCOMPLETE SITE PLANS WILL BE RETURNED TO YOU FOR COMPLETION AND MAY RESULT IN A DELAY IN THE ISSUANCE OF YOUR SEPTIC SYSTEM PERMIT!!!*

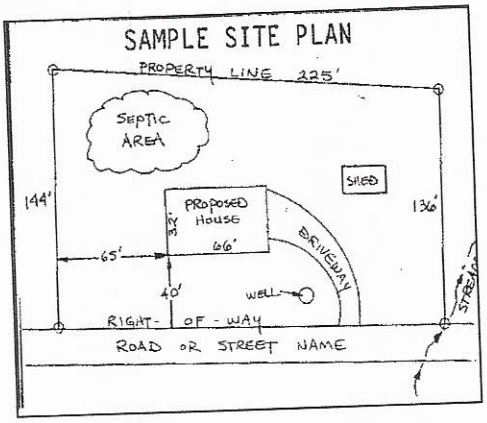

Place an (X) beside each item as you complete the site plan:

( ) Property Line measurements are clearly identified
( ) All proposed structures are indicated
( ) Front and side setbacks from property line
( ) Preferred driveway location and well location
( ) Area you prefer your septic system to be placed
( ) North arrow, or other sufficient indicator of direction

Circle N/A on the following if appropriate:

Location of septic systems and wells within 100' of your property	N/A
Location of easements and rights of ways on your property	N/A
Location of any designated wetlands on the property	N/A

USE THIS SPACE TO DRAW YOUR SITE PLAN

Show: proposed house or business footprint, wells, water lines, patios, pools and decks, and any other item that will occupy space on the site

see septic permit

Signature: _____
Property owner or owner's legal representative signature (SIGNATURE REQUIRED)

6-3-2024
DATE

IREDELL COUNTY HEALTH DEPARTMENT

(SEPTIC TANK) IMPROVEMENTS PERMIT AND CERTIFICATE OF COMPLETION
(Ground Absorption Sewage Disposal System -- G. S. Chapter 130-Article 13C)

OWNER OR CONTRACTOR Robert Harkey DATE 9-23-91 PERMIT NO. _____

PHONE: Business _____ Home _____

LOCATION Elmwood Rd Turn on Longview 1st mH on left.

SUBDIVISION NAME _____ LOT NO. _____ SECTION OR BLOCK NO. _____ S. R. No. _____

House ( ) Mobile Home (✓) Business ( ) Other Repair


No. Bedrooms _____ No. Bathrooms _____

Garbage Disposal Unit	Yes ( )	No ( )
Auto. Dishwasher	Yes ( )	No ( )
Auto. Wash. Machine	Yes ( )	No ( )
Site Suitable	Yes ( )	No ( )

Lot Area _____

Character & Porosity of Soil _____
Percolation Rate _____
Topography _____
Depth to Water Table EX.
Rock or other impervious formations _____

_____ Basement with Plumbing _____ Basement without Plumbing _____ No Basement

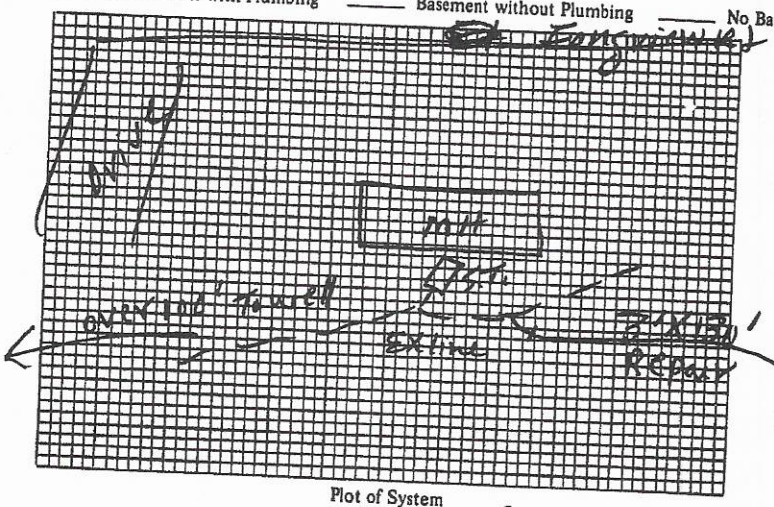

Plot of System

Size of Tank EX. Gals.
Nitrification Field:
No. of Lines 1
Sq. Ft. 390 Linear Ft. 130
Depth of Stone in Lines 12"
Water Supply: Individual (✓)
Public ( )

Installed by AAA Enterprizes

I understand and agree to install septic tank system as specified on this Improvements Permit.

Signed: _____

IMPROVEMENTS PERMIT BY L. C. Moore

COMMENTS: _____

CERTIFICATE OF COMPLETION BY _____

EXISTING SYSTEM CHECKED BY: L. C. Moore DATE 9-23-91

CONSTRUCTION MUST COMPLY WITH ALL OTHER APPLICABLE STATE AND LOCAL REGULATIONS. DATE _____

Permit is VOID if any unauthorized changes are made in installation of system and/or if any false information is supplied in making Improvements Permit.

Health Dept. Copy: White Inspection Dept. Copy: Yellow Sanitarian's Copy: Pink Owner's Copy: Gold