IREDELL COUNTY HEALTH DEPARTMENT

Statesville Office (704) 878-5305 Mooresville Office (704) 660-3625 PERMIT # 217004

IMPROVEMENT PERMIT / AUTHORIZATION TO CONSTRUCT / OPERATION PERMIT / EXISTING SYSTEM

PIN # 4784143185

APPLICANT: Walter Janvrin APPLICANT ADDRESS: 121 Shovelhead Ln.

SITE ADDRESS: 130 Shovelhead Ln. PHONE: 704-929-0538 ALT. PHONE: N/A

SITE DIRECTIONS: Hwy 64 E TR Barnes Oak Rd TR Elmwood Rd TL Shovelhead Ln.


SUBDIVISION: N/A SECTION: N/A LOT # N/A LOT AREA: 1.245 acres DESIGN FLOW: 360gpd L.T.A.R.: Existing

Septic Tank	Existing	(gal)	STB		Date		☐ New System	☐ Repair	☐ Expansion	System Type: I (II) III IV V VI	☑ Residence	No. Bedrooms	3	Water Supply	
Pump Tank		(gal)	PT		Date		System Description:	Existing			☐ Business	No. Persons	6	☐ Private	
Pump Make		Model			Serial #		Repair System Description:				☐ Other	No. Employees		☑ Public	
# Nitrification Fields	Ex	# Lines	Ex		Linear Ft:	Ex	Maintenance Agreement Required:	☐ YES	☑ NO		☐ Slab	☑ Crawl Space		☐ Community	
Trench Width	Ex	Max. Trench Bottom Depth	Ex		Gravel Depth	Ex		☑ GRAVITY	☐ PRESSURE		☐ Basement w/plumbing			☐ Basement w/o plumbing	


Comments / Conditions:

- Maintain a minimum of 10' between building foundation & all components of septic tank system.

INITIAL SITE SKETCH

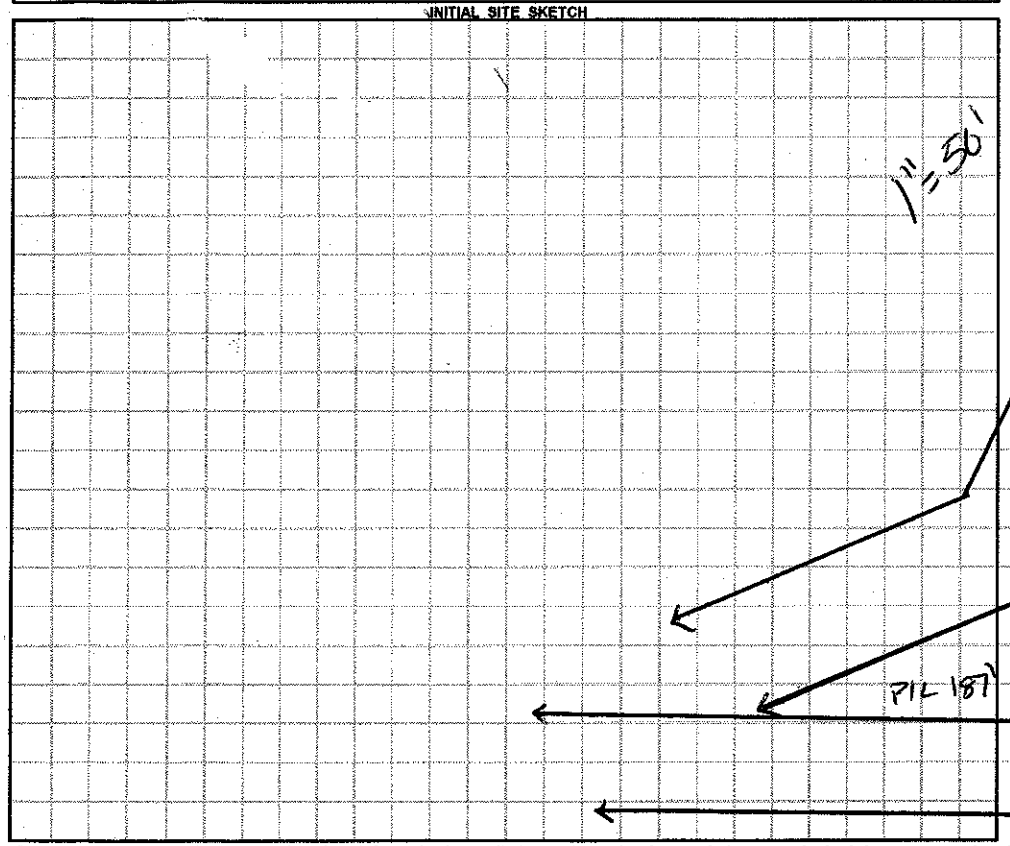

AS BUILT SKETCH

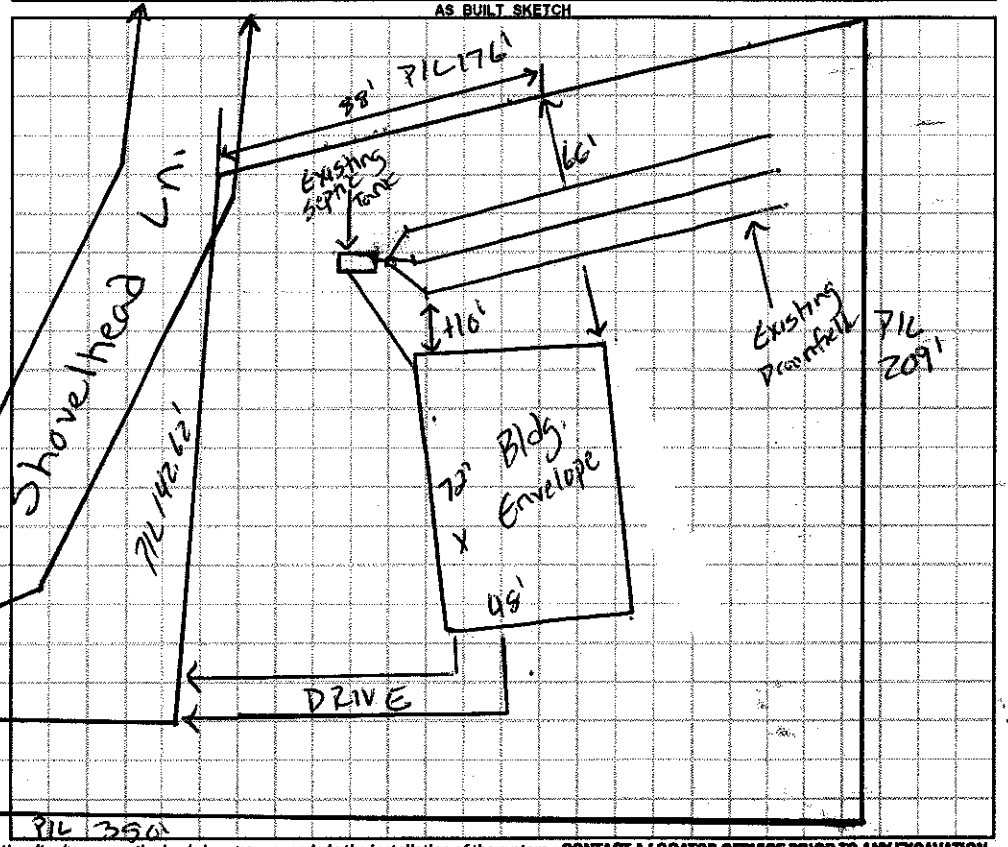

Permit can be suspended or revoked if any false information is supplied toward securing the permit / any unauthorized changes are made to the site / any unauthorized changes are made in the installation of the system. **CONTACT A LOCATOR SERVICE PRIOR TO ANY EXCAVATION**

☐ **IMPROVEMENT PERMIT** *with plat valid without expiration.* ☐ **IMPROVEMENT PERMIT** *with site plan valid for 60 mos.* ☐ **AUTHORIZATION TO CONSTRUCT** *valid for period equal to IMPROVEMENT PERMIT--not to exceed 60 mo.*

Owner / Applicant Signature: Margie J Janvrin Date: 5-13-16 Installed by:

IMPROVEMENT PERMIT by: Date: OPERATION PERMIT by: Date:

AUTHORIZATION TO CONSTRUCT by: Date: Existing System Inspected by: Justin Henderson Date: 5-13-16

Health Dept. Copy - WHITE Applicant (Final Approval) - YELLOW Applicant (Conditional Approval) - PINK