IREDELL COUNTY HEALTH DEPARTMENT

STATESVILLE 704-878-5305 MOORESVILLE 704-664-5281 CF

IMPROVEMENT PERMIT / AUTHORIZATION TO CONSTRUCT / OPERATION PERMIT / EXISTING SYSTEM INSPECTION

PERMIT# 108272 PIN# 4784-23-5363.B

OWNER OR CONTRACTOR RAY ANDERSON PHONE Business Home 704-873-4998 DATE 09-10-02

ADDRESS 2343 SALISBURY HWY STATESVILLE, NC 28677

LOCATION HWY 70 EAST, L ELMWOOD, R LONGVIEW, CROSS BRIDGE & NEXT DRIVE ON LEFT, ALL WAY TO END

SUBDIVISION BLOCK / SECTION LOT LOT AREA 32 AC SITE CLASS PS DESIGN FLOW 360 L.T.A.R. .3

Septic Tank: 1000 Gallons: STB 1012 Date 12-14-01
Pump Tank: Gallons: PT Date
Pump Make: Model Serial No
Nitrification Field: No Fields 1 Square Feet 1200' Linear Feet 400'
No Lines 4x100' Trench Width 36" Max Trench Bottom Depth 36" Gravel Depth 12"

X New System ☐ Repair System Type: I II III IV V
System Description: CONV GRAV
Repair System Description: CONV GRAV
Maintenance Agreement Required: ☐ Yes X No


X House/Mod. Home No. Bedrooms 3
☐ Mobile Home No. Bathrooms 2
☐ Business No. Employees
☐ Other
☐ Slab X Crawl Space ☐ Basement w/plumbing ☐ Basement wo/plumbing

Water Supply: ☐ Individual X Public ☐ Community

Comments/Conditions: ① GRADED OFF 24" OF SOIL TO GET TO useable saprolite ② CALL PRIOR TO INSTALLATION FOR CONSULTATIVE VISIT & FLAGOUT ③ DO SOME FINISH UP GRADING TO GET THE CONTOURS AS DRAWN

Comments/Conditions ④ USE 4 DROP BOXES ⑤ THIS IS A SAPROLITE SYSTEM.

INITIAL SITE SKETCH "NOT TO SCALE"

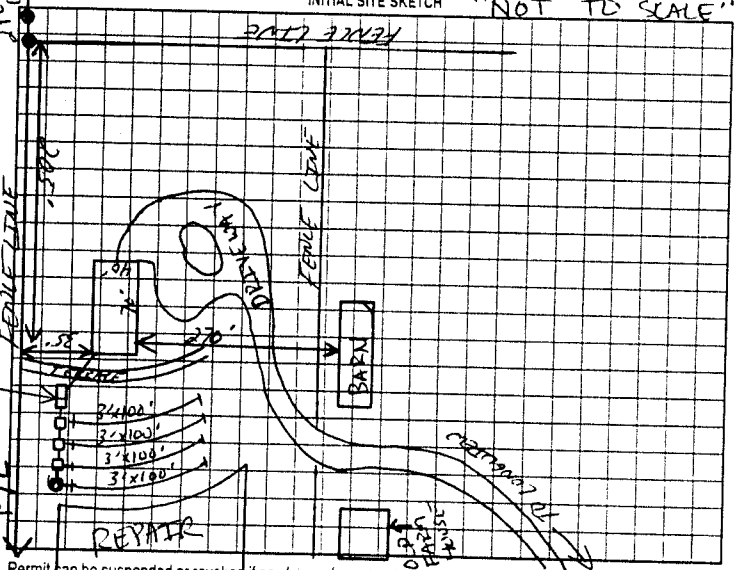

AS BUILT SKETCH

MARKERS & TUFF TITE FLAGS
CAST BOX ELIMINATED 4 DROP BOXES
FS AIR I WITH SPLIT LEVELER

Permit can be suspended or revoked if any false information is supplied toward securing the permit, any unauthorized changes are made to the site, any unauthorized changes are made in the installation of the system. Improvement Permit with plan valid without expiration. Improvement Permit with site plan valid for sixty months. Authorization to Construct is valid for a period equal to that of Improvement Permit – not to exceed sixty months

Signed: Ray A Anderson date 09-11-02 Installed by JIM LENTZ

Improvement Permit by: date 09-10-02 Operation Permit by date 10-7-02

Authorization to Construct by: date 09-10-02 Existing System Inspection by: date

HEALTH DEPT COPY WHITE OWNER COPY (FINAL) YELLOW OWNER COPY (INITIAL) PINK