IREDELL COUNTY HEALTH DEPARTMENT

STATESVILLE 704-878-5305 MOORESVILLE 704-664-5281

IMPROVEMENT PERMIT / AUTHORIZATION TO CONSTRUCT / OPERATION PERMIT / EXISTING SYSTEM INSPECTION

PERMIT# 156074 PIN# 4784-32-7406 DATE 3-28-11

OWNER OR APPLICANT Kevin + Teresa Williams PHONE: Business 704 880 3068 Home

ADDRESS 541 Longview

LOCATION 541 Longview – 64 E, (R) on Barry Oak (R) on Longview, house on (L)

SUBDIVISION n/a BLOCK / SECTION n/a LOT n/a LOT AREA n/a SITE CLASS. PS DESIGN FLOW 360 (ex) L.T.A.R. ex

Septic Tank: Ex Gallons: STB Date

Pump Tank: Gallons: PT Date

Pump Make: Model Serial No.

Nitrification Field: No Fields Ex Square Feet Ex Linear Feet 300

No Lines Ex Trench Width Ex Max Trench Bottom Depth Ex Gravel Depth Ex

☐ New System ☐ Repair ☐ Expansion System Type: I (II) III IV V VI

System Description: Existing Gravity Conv.

Repair System Description:

Maintenance Agreement Required: ☐ Yes ☒ No

☒ House/Mod. Home No. Bedrooms 3

☐ Mobile Home No. Persons

☐ Business No. Employees

☐ Other

Water Supply: ☐ Individual ☐ Public ☒ Community

☒ Gravity ☐ Pressure ☐ Slab ☒ Crawl Space ☐ Basement w/plumbing ☐ Basement wo/plumbing

Comments/Conditions:


Comments/Conditions:

Wells must be abandoned before new house is built in place of old house. System has not been in operation - no signs of failure

INITIAL SITE SKETCH

- Maintain ≥ 5' from all parts of septic with house
- No traffic over septic area

AS BUILT SKETCH

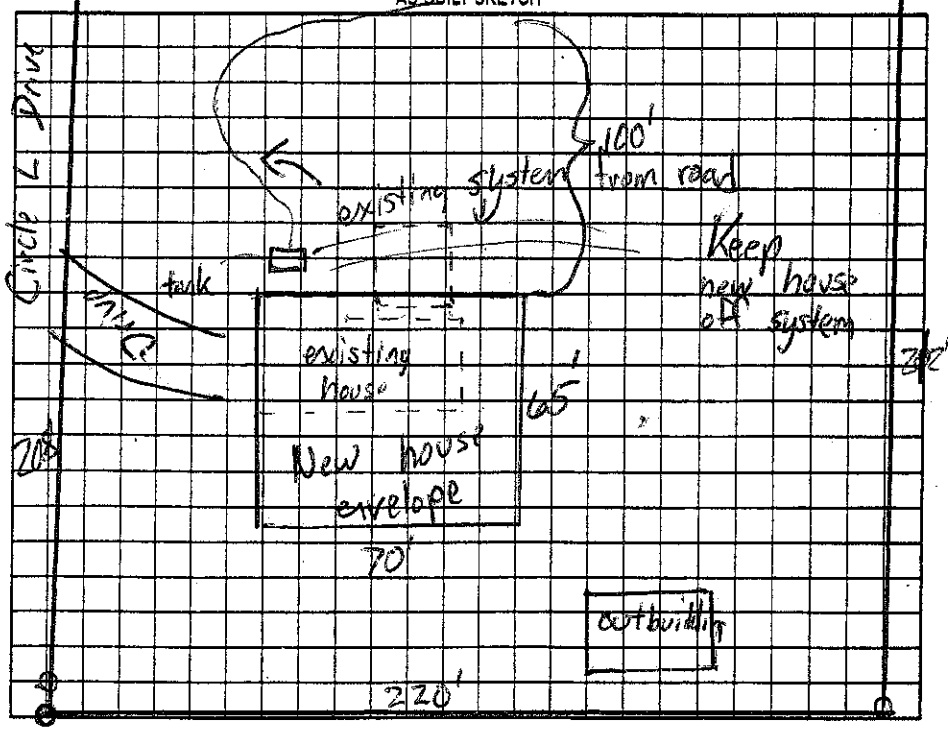

Permit can be suspended or revoked if any false information is supplied toward securing the permit/any unauthorized changes are made to the site/any unauthorized changes are made in the installation of the system. Improvement Permit with plat valid without expiration ☐ Improvement Permit with site plan valid for sixty months ☒ Authorization to Construct is valid for a period equal to that of Improvement Permit – not to exceed sixty months.

Signed: Billy Hall date 4-15-11 Installed by:

Improvement Permit by: date Operation Permit by: date

Authorization to Construct by: date Existing System Inspection by: James Ott date 3-28-11

HEALTH DEPT. COPY: WHITE OWNER COPY (FINAL): YELLOW OWNER COPY (INITIAL): PINK