IREDELL COUNTY HEALTH DEPARTMENT

STATESVILLE 704-878-5305 MOORESVILLE 704-664-5281

IMPROVEMENT PERMIT / CERTIFICATE OF COMPLETION / OPERATION PERMIT / EXISTING SYSTEM INSPECTION

PROPERTY DESCRIPTION NO. 25956 DATE 5-13-97 TAX MAP NO. 4784395392 Watershed: ☐ Yes ☐ No

OWNER OR CONTRACTOR Alwyn Wilhelm PHONE: Business Home 878 9809

ADDRESS 186 Longview Rd Statesville

LOCATION 64E TR Barrop oak TR Longview 1/2 mile on Right

SUBDIVISION Alwyn Wilhelm BLOCK / SECTION LOT 2 LOT AREA 1 acre SITE CLASS. AS DESIGN FLOW 340 L.T.A.R. .28

Septic Tank: 1000 Gallons; STB Presnell X1012 Date 4-18-97

Pump Tank: Gallons; PT Date

Pump Make: Model Serial No.

Nitrification Field: No Fields 4 Square Feet 900 Linear Feet 300

No Lines 3 Trench Width 36" Max Trench Bottom Depth 36" Gravel Depth 12"

☑ New System ☐ Repair System Type: I, II, III, IV, V, VI

System Description: Conv. Gravity

Repair System Description: " "

Maintenance Agreement Required: ☐ Yes ☑ No

☐ House/Mod. Home No. Bedrooms 2

☑ Mobile Home No. Bathrooms 2

☐ Business No. Employees

☐ Other


☐ Slab ☑ Crawl Space ☐ Basement w/plumbing ☐ Basement wo/plumbing

Water Supply: ☑ Individual ☐ Community ☐ Public


Comments:

Comments:

INITIAL SITE SKETCH

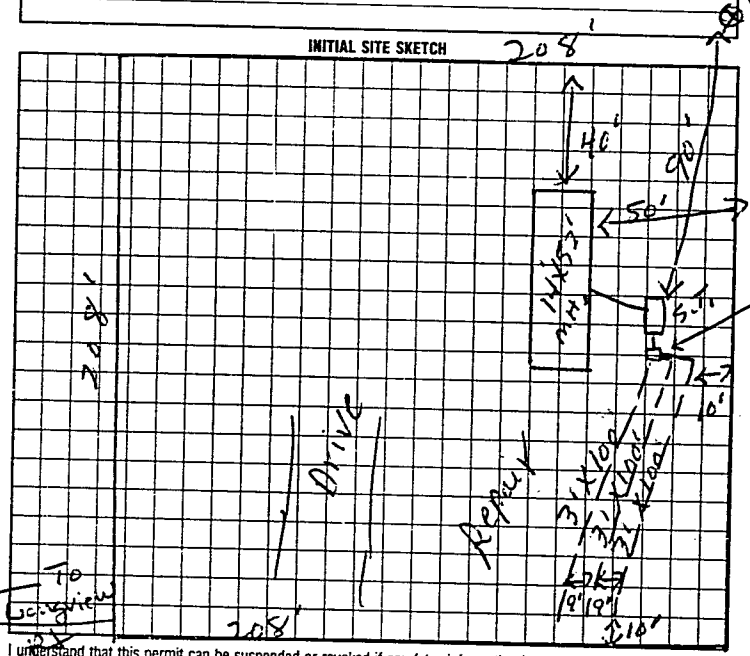

AS BUILT SKETCH

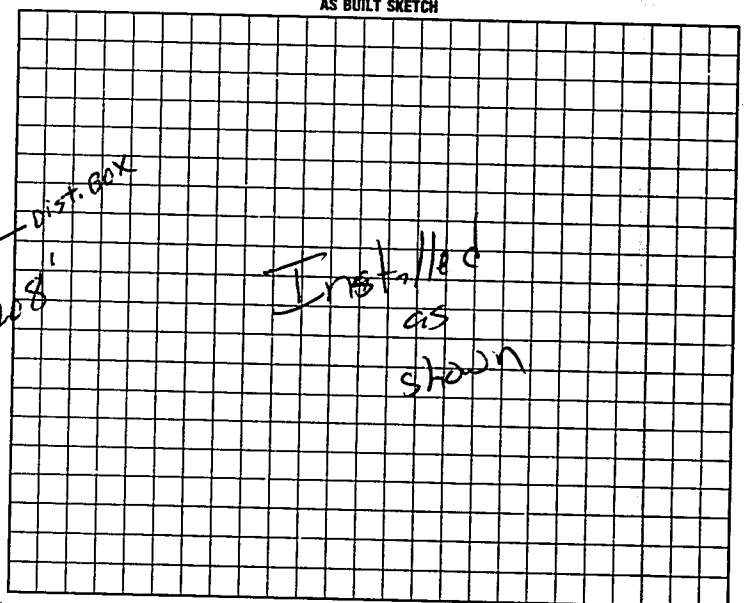

I understand that this permit can be suspended or revoked if any false information is supplied toward securing the permit/any unauthorized changes are made to the site/any unauthorized changes are made in the installation of the system. Improvement Permit is valid for 60 months from date of issuance.

Signed: Alwyn Wilhelm

Improvement Permit by: P.C. Moore date 5-13-97

Authorization to Construct/Existing System Inspection by: P.C. Moore date 5-13-97

Installed by: Steve Jordan

Certificate of Completion by: date

Operation Permit by: Mark C. Oaks RS date 6-12-97

to COUNTY DEPT. COPY WHITE INSPECTION COPY (FINAL) GREEN OWNER COPY (FINAL) YELLOW INSPECTION COPY (INITIAL) PINK OWNER COPY (INITIAL) GOLD

Authorization to Const. Expires 60 mos from issue

00243