IREDELL COUNTY HEALTH DEPARTMENT

STATESVILLE 704-878-5305 MOORESVILLE 704-664-5281

IMPROVEMENT PERMIT / CERTIFICATE OF COMPLETION / OPERATION PERMIT / EXISTING SYSTEM INSPECTION

PROPERTY DESCRIPTION NO. 25390 DATE 1-6-97 TAX MAP NO. 5Q-A-79 Watershed: ☐ Yes ☑ No

OWNER OR CONTRACTOR Alwyn Wilhelm PHONE: Business _____ Home 872-5736

ADDRESS 186 Longview Rd

LOCATION 64E TR8 Barn Oaks TR Longview Rd 1/4 mile on Rt

SUBDIVISION _____ BLOCK / SECTION _____ LOT ~~None~~ LOT AREA 1 acre SITE CLASS. PS DESIGN FLOW 240 L.T.A.R. .28

Septic Tank: 1000 Gallons; STB 1012 Date 4-15-97

Pump Tank: _____ Gallons; PT _____ Date _____

Pump Make: _____ Model _____ Serial No. _____

Nitrification Field: No Fields 1 Square Feet 900 Linear Feet 300

No Lines 2 Trench Width 36" Max Trench Bottom Depth 24" Gravel Depth 12"

☑ New System ☐ Repair System Type: I, II, III, IV, V, VI

System Description: Conv. Gravity

Repair System Description: " "

Maintenance Agreement Required: ☐ Yes ☑ No

☐ House/Mod. Home ☑ Mobile Home ☐ Business ☐ Other

No. Bedrooms 2 No. Bathrooms 2 No. Employees _____

☐ Slab ☑ Crawl Space ☐ Basement w/plumbing ☐ Basement wo/plumbing


Water Supply: ☑ Individual ☐ Community ☐ Public

Comments:


208'

Comments:

INITIAL SITE SKETCH

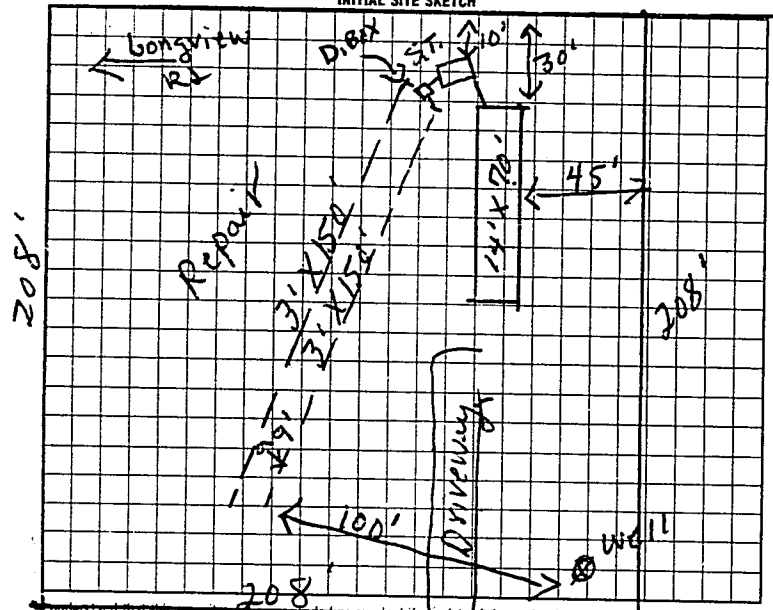

AS BUILT SKETCH

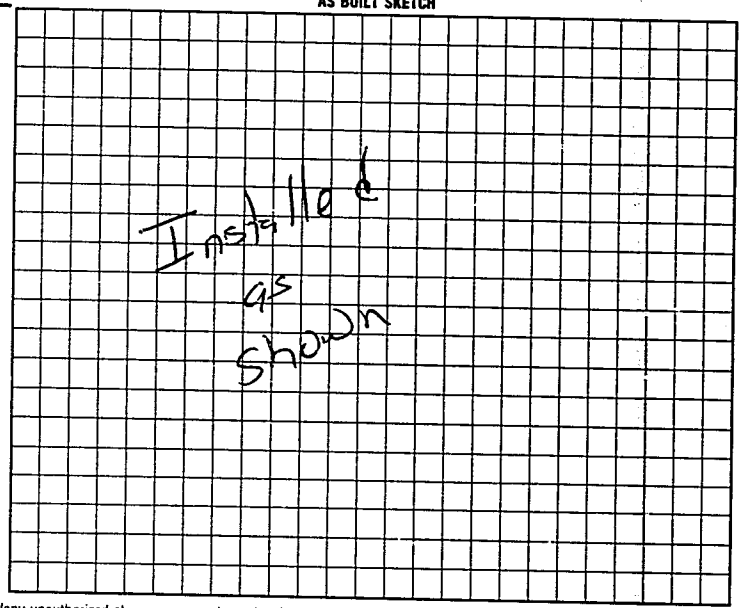

I understand that this permit can be suspended or revoked if any false information is supplied toward securing the permit/any unauthorized changes are made to the site/any unauthorized changes are made in the installation of the system. Improvement Permit is valid for 60 months from date of issuance.

Signed: X Alwyn Wilhelm

Improvement Permit by: P.C. Moore date 1-6-97

Authorization to Construct P.C. Moore date 1-6-97

Installed by: Steve Jolden

Certificate of Completion by: _____ date _____

Operation Permit by Mark C. Oakes date 6-12-97

Authorization to Const. Expires 60 mos from issue.

Existing System Inspection by _____ date _____

APPLICANT COPY: WHITE INSPECTION COPY (FINAL): GREEN OWNER COPY (FINAL): YELLOW INSPECTION COPY (INITIAL): PINK OWNER COPY (INITIAL): GOLD