IREDELL COUNTY HEALTH DEPARTMENT

STATESVILLE 704-878-5305 MOORESVILLE 704-664-5281

IMPROVEMENT PERMIT / AUTHORIZATION TO CONSTRUCT / OPERATION PERMIT / EXISTING SYSTEM INSPECTION

PERMIT# 093388 PIN# 4784 45 1360 (PT) DATE 12-21-00

OWNER OR CONTRACTOR STEPHEN MARK LITLE PHONE: Business Home

ADDRESS 396 LONGVIEW ROAD, STATESVILLE, NC 28625

LOCATION US 64 E, TR BARRY OAK RD, TR LONGVIEW RD, 1.1 MILES ON RIGHT

SUBDIVISION BLOCK / SECTION LOT LOT AREA 0.71 ACRES SITE CLASS. PS DESIGN FLOW 360 L.T.A.R. 0.20 GPD/FT²

Septic Tank: 1000 Gallons; STB 1007 Date 11-23-00
Pump Tank: Gallons; PT Date
Pump Make: Model Serial No
Nitrification Field: No Fields 1 Square Feet 1800 Linear Feet 600
No Lines EIGHT Trench Width 36" Max Trench Bottom Depth 36" Gravel Depth 12"

☑ New System ☐ Repair System Type: I (II) III. IV. V. VI
System Description: CONVENTIONAL GRAVITY
Repair System Description: CONV. PUMP
Maintenance Agreement Required: ☐ Yes ☑ No


☑ House/Mod. Home No. Bedrooms 3
☐ Mobile Home No. Bathrooms 2
☐ Business No. Employees
☐ Other
☐ Slab ☑ Crawl Space ☐ Basement w/plumbing ☐ Basement wo/plumbing

Water Supply: ☑ Individual ☐ Public ☐ Community WELL NEXT DOOR


Comments/Conditions: USE ONE FLOW DIVIDER TEE TO ACHIEVE EQUAL DISTRIBUTION INTO TWO DISTRIBUTION BOXES FEEDING FOUR LINES EACH

Comments/Conditions: SEPTIC TANK WITH MARKER INSTALLED USING "PolyLok" FITTER

INITIAL SITE SKETCH

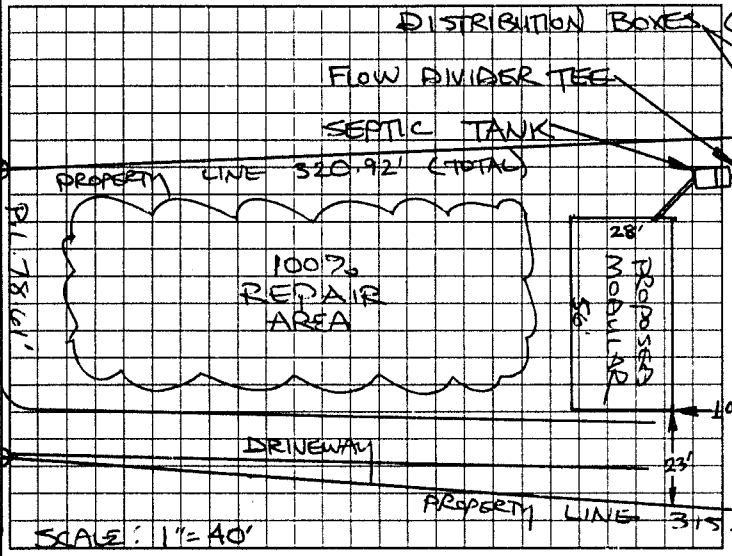

AS BUILT SKETCH

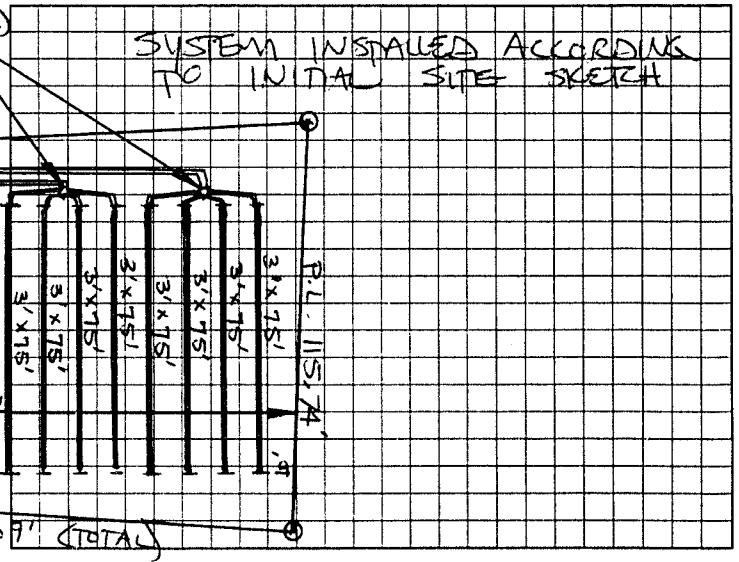

LONGVIEW ROAD (SR2309)

Permit can be suspended or revoked if any false information is supplied toward securing the permit/any unauthorized changes are made to the site/any unauthorized changes are made in the installation of the system. Improvement Permit with plat valid without expiration. Improvement Permit with site plan valid for sixty months. Authorization to Construct is valid for a period equal to that of Improvement Permit – not to exceed sixty months.

Signed: Stephen Mark Litle date Installed by: JAMES HYDER

Improvement Permit by: STEVE HEDRICK date 12-21-00 Operation Permit by: STEVE HEDRICK date 2/01/01

Authorization to Construct by: STEVE HEDRICK date 12-21-00 Existing System Inspection by: date

HEALTH DEPT COPY WHITE OWNER COPY (FINAL) YELLOW OWNER COPY (INITIAL) PINK