IREDELL COUNTY HEALTH DEPARTMENT

STATESVILLE 704-878-5305 MOORESVILLE 704-664-5281

IMPROVEMENT PERMIT / AUTHORIZATION TO CONSTRUCT / OPERATION PERMIT / EXISTING SYSTEM INSPECTION

PERMIT# 131823 PIN# 4784-45-1669 DATE 10-19-05

OWNER OR CONTRACTOR DONALD & PATSY MOORE PHONE: Business Home 704-873-3178

ADDRESS 370 LONGVIEW ROAD, STATESVILLE NC 28625-1174

LOCATION US 64 E, TR BARRY OAK ROAD, TR LONGVIEW ROAD, 1.0 MILE ON RIGHT AT #370

SUBDIVISION BLOCK / SECTION LOT LOT AREA 2.103 ACRES SITE CLASS. PS DESIGN FLOW 360 L.T.A.R. 0.4 (EXISTING)

Septic Tank: 1000 Gallons; STB Date

Pump Tank: Gallons; PT Date

Pump Make: Model Serial No.

Nitrification Field: No Fields 1 Square Feet 900 Linear Feet 300

No Lines TWO Trench Width 36" Max Trench Bottom Depth Gravel Depth 12"

☐ New System ☐ Repair System Type: I, (II), III, IV, V, VI

System Description: CONVENTIONAL, GRAVITY

Repair System Description:

Maintenance Agreement Required: ☐ Yes ☑ No

☑ House/Mod. Home No. Bedrooms 3

☐ Mobile Home No. Bathrooms

☐ Business No. Employees

☐ Other

☐ Slab ☑ Crawl Space ☐ Basement w/plumbing ☐ Basement wo/plumbing

Water Supply: ☑ Individual ☐ Public ☐ Community


WELL

Comments:/Conditions:


Comments:/Conditions: ① SYSTEM UNDERSIZED ACCORDING TO TODAY'S STANDARDS.

② EXISTING HOME TO BE REMOVED UPON OCCUPANCY of NEW HOME

INITIAL SITE SKETCH

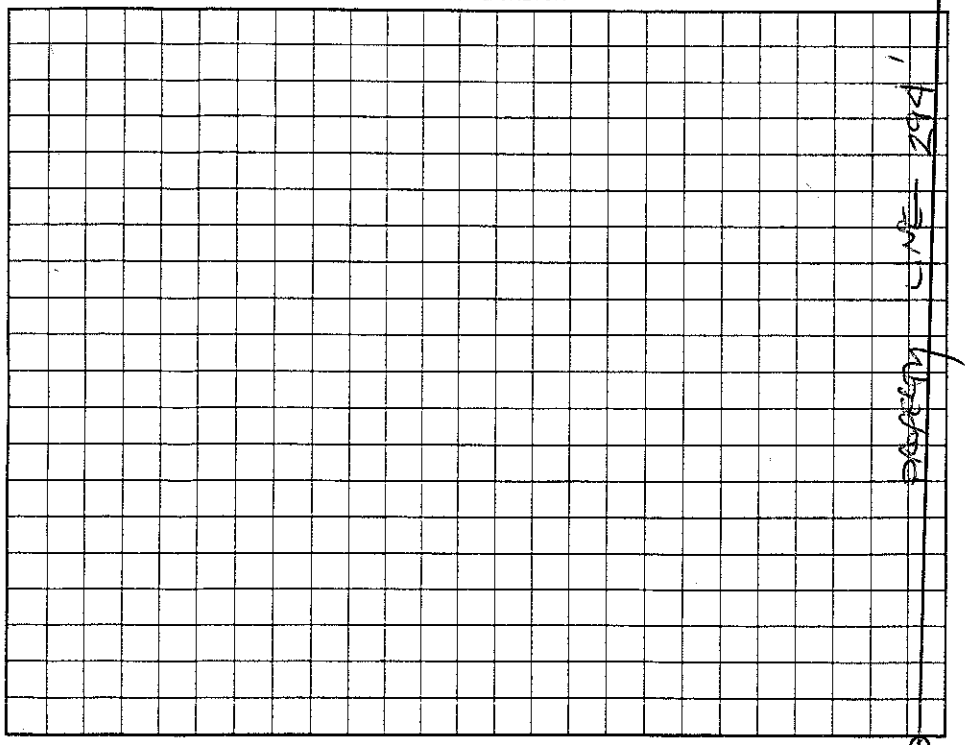

AS BUILT SKETCH

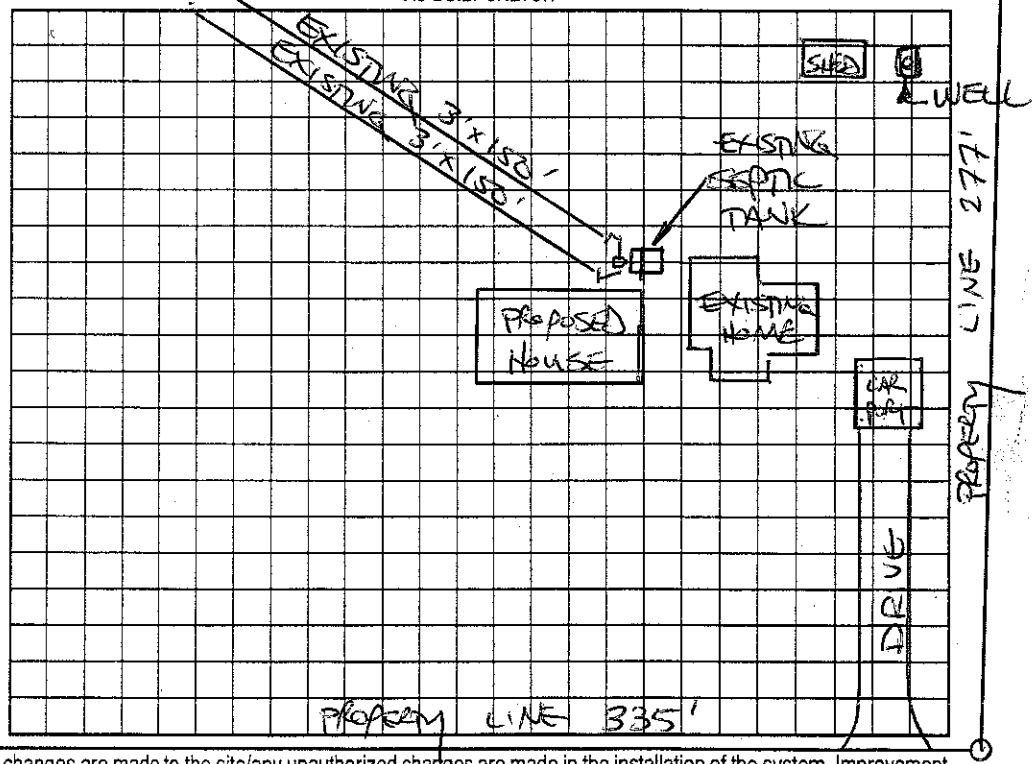

Permit can be suspended or revoked if any false information is supplied toward securing the permit/any unauthorized changes are made to the site/any unauthorized changes are made in the installation of the system. Improvement Permit with plat valid without expiration. Improvement Permit with site plan valid for sixty months. Authorization to Construct is valid for a period equal to that of Improvement Permit – not to exceed sixty months.

Signed: date Installed by:

Improvement Permit by: date Operation Permit by: date

Authorization to Construct by: date Existing System Inspection by: STEVE HENDRICK date 10-19-05

HEALTH DEPT. COPY: WHITE OWNER COPY (FINAL): YELLOW OWNER COPY (INITIAL): PINK