IREDELL COUNTY HEALTH DEPARTMENT

STATESVILLE 704-878-5305 MOORESVILLE 704-664-5281

IMPROVEMENT PERMIT / CERTIFICATE OF COMPLETION / OPERATION PERMIT / EXISTING SYSTEM INSPECTION

PROPERTY DESCRIPTION NO. 19645 DATE 10-27-94 TAX MAP NO. 5a-A-22 Watershed: ☐ Yes ☑ No

OWNER OR CONTRACTOR Steve Harkey PHONE: Business _____ Home 876 1500

ADDRESS 156 Bonnie Lane

LOCATION 64E TR Barry oak TR Barnhill at Co. Line back out in field on Rt

SUBDIVISION _____ BLOCK / SECTION _____ LOT _____ LOT AREA 30 acres SITE CLASS. PS DESIGN FLOW 480 L.T.A.R. .13

Septic Tank: 1000 Gallons; STB 1017 Date 12-17-94

Pump Tank: _____ Gallons; PT _____ Date _____

Pump Make: _____ Model _____ Serial No. _____

Nitrification Field: No Fields 1 Square Feet 1600 Linear Feet 533

No Lines 4 Trench Width 36" Max Trench Bottom Depth 24" Gravel Depth 12"

☑ New System ☐ Repair System Type: I (II) III, IV, V, VI

System Description: conv. trench

Repair System Description: " "

Maintenance Agreement Required: ☐ Yes ☐ No

☑ House/Mod. Home No. Bedrooms 4

☑ Mobile Home No. Bathrooms 3

☐ Business No. Employees _____

☐ Other _____


☐ Slab ☑ Crawl Space ☐ Basement w/plumbing ☐ Basement wo/plumbing

Water Supply: ☑ Individual ☐ Community ☐ Public

Comments:

Comments: mobile Home To be used until house is built Then mobile Home must be taken off systems.

INITIAL SITE SKETCH

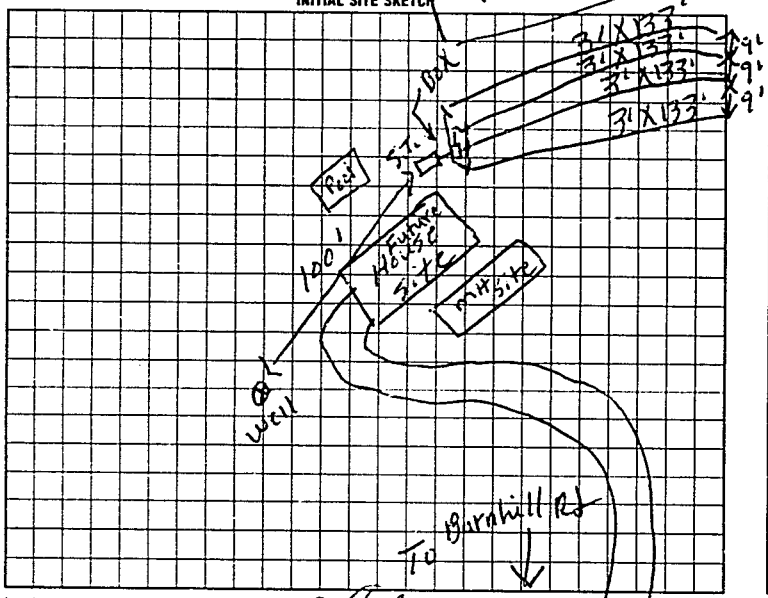

AS BUILT SKETCH

Same as initial sketch

I understand that this permit can be suspended or revoked if any false information is supplied toward securing the permit/any unauthorized changes are made to the site/any unauthorized changes are made in the installation of the system. Improvement Permit is valid for 60 months from date of issuance.

Signed: X

Improvement Permit by: R.E. Moore date 10-27-94

Existing System Inspection by: _____ date _____

Installed by: Tommy Fryar

Certificate of Completion by: F.C. Moore date 2-8-95

Operation Permit by: _____ date _____

HEALTH DEPT. COPY: WHITE INSPECTION COPY (FINAL): GREEN OWNER COPY (FINAL): YELLOW INSPECTION COPY (INITIAL): PINK OWNER COPY (INITIAL): GOLD