IREDELL COUNTY HEALTH DEPARTMENT

STATESVILLE 704-878-5305 MOORESVILLE 704-664-5281

IMPROVEMENT PERMIT / AUTHORIZATION TO CONSTRUCT / OPERATION PERMIT / EXISTING SYSTEM INSPECTION

PERMIT# 095674 PIN# 4784 78 1341 DATE 04-12-01

OWNER OR CONTRACTOR ROBERT HARVEY PHONE: Business Home 704-871-8564

ADDRESS 325 BARNHILL RD, [redacted] CLEVELAND, NC 27013

LOCATION HWY 64E, (R) BARRY OAK, (R) BARNHILL, (@) 1 mile on Left

SUBDIVISION BLOCK / SECTION LOT LOT AREA 11.93 SITE CLASS. DESIGN FLOW 360 L.T.A.R. .28

EXISTING

Septic Tank: 1250 Gallons: STB Date

Pump Tank: Gallons: PT Date

Pump Make: Model Serial No

Nitrification Field: No Fields 1 Square Feet 1350 Linear Feet 450

No Lines 3 Trench Width 36" Max Trench Bottom Depth 36" Gravel Depth 12"

☐ New System ☐ Repair System Type: I. II. III. IV. V. VI

System Description: EXISTING

Repair System Description:

Maintenance Agreement Required: ☐ Yes ☐ No

☒ House/Mod. Home No. Bedrooms 3

☐ Mobile Home No. Bathrooms 1½

☐ Business No. Employees

☐ Other

☐ Slab ☐ Crawl Space ☐ Basement w/plumbing ☐ Basement wo/plumbing


Water Supply: ☒ Individual ☐ Public ☐ Community

well


Comments/Conditions: ① KEEP HOUSE ATLEAST 5' from any part of system. ② INITIAL SYSTEM INSTALLED 8-23-97.

Comments/Conditions:

INITIAL SITE SKETCH

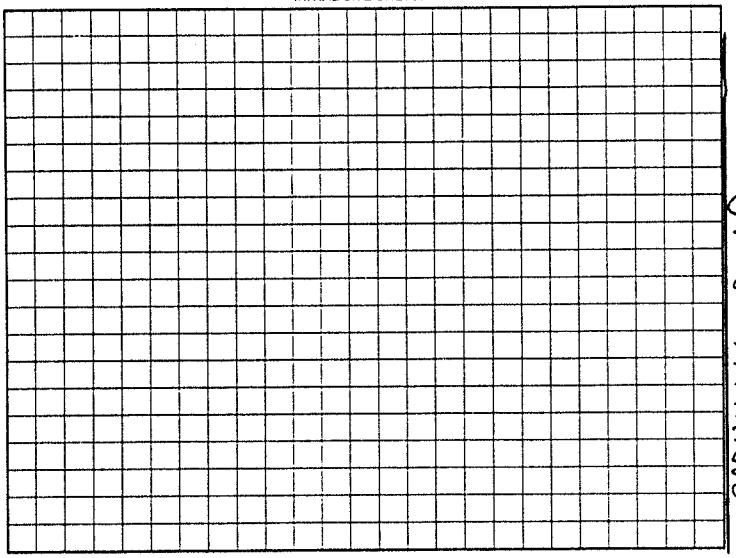

AS BUILT SKETCH

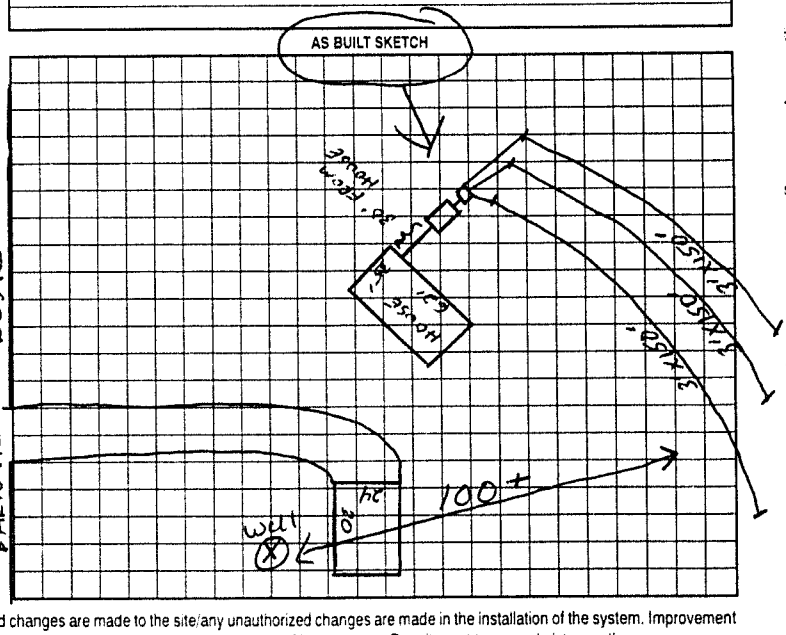

Permit can be suspended or revoked if any false information is supplied toward securing the permit/any unauthorized changes are made to the site/any unauthorized changes are made in the installation of the system. Improvement Permit with plat valid without expiration. Improvement Permit with site plan valid for sixty months. Authorization to Construct is valid for a period equal to that of Improvement Permit – not to exceed sixty months.

Signed: Janet Harvey date 4-11-01 Installed by: PAT MURPHY

Improvement Permit by: date Operation Permit by: date

Authorization to Construct by: date Existing System Inspection by: Tim Cook REHS date

HEALTH DEPT. COPY: WHITE OWNER COPY (FINAL): YELLOW OWNER COPY (INITIAL): PINK