2

IREDELL COUNTY HEALTH DEPARTMENT

STATESVILLE 704-878-5305 MOORESVILLE 704-664-5281 52501

IMPROVEMENT PERMIT / CERTIFICATE OF COMPLETION / OPERATION PERMIT / EXISTING SYSTEM INSPECTION

PROPERTY DESCRIPTION NO. 18564 DATE 8-18-94 TAX MAP NO. 5Q - A - 101 Watershed: ☐ Yes ☑ No

OWNER OR CONTRACTOR Robert Harkey PHONE: Business _____ Home 872-4943

ADDRESS _____

LOCATION 648 Longview Rd TR Barry oak TR Barnhill at co line on left

SUBDIVISION _____ BLOCK / SECTION _____ LOT _____ LOT AREA 11.97 acres SITE CLASS _____ DESIGN FLOW _____ L.T.A.R. .28

Septic Tank: 1250 Gallons; STB _____ Date _____

Pump Tank: _____ Gallons; PT _____ Date _____

Pump Make: _____ Model _____ Serial No. _____

Nitrification Field: No Fields 1 Square Feet 1350 Linear Feet 450

No Lines 3 Trench Width 36" Max Trench Bottom Depth 36" Gravel Depth 12"

☐ New System ☐ Repair System Type: I, II, III, IV, V, VI

System Description: _____

Repair System Description: _____

Maintenance Agreement Required: ☐ Yes ☐ No

☑ House/Mod. Home No. Bedrooms 3

☐ Mobile Home No. Bathrooms 1 1/2

☐ Business No. Employees _____

☐ Other _____

☐ Slab ☑ Crawl Space ☐ Basement w/plumbing ☐ Basement wo/plumbing


Water Supply: ☑ Individual ☐ Community ☐ Public

Comments:

Comments: Building house To Replace Ex. mobile Home. mobile Home must be Taken off System before House is occupied or Cert. of occupancy is issued

INITIAL SITE SKETCH

AS BUILT SKETCH

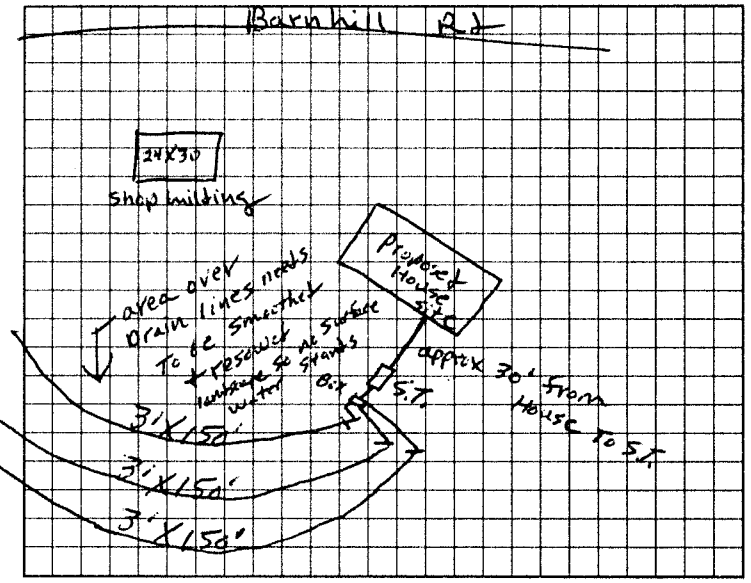

I understand that this permit can be suspended or revoked if any false information is supplied toward securing the permit/any unauthorized changes are made to the site/any unauthorized changes are made in the installation of the system. Improvement Permit is valid for 60 months from date of issuance.

Signed: _____ Installed by: Pat murphy

Improvement Permit by: _____ date _____ Certificate of Completion by: L. C. moore date 9-23-94

Existing System Inspection by: L. C. moore date 8-18-94 Operation Permit by: _____ date _____

HEALTH DEPT. COPY: WHITE INSPECTION COPY (FINAL): GREEN OWNER COPY (FINAL): YELLOW INSPECTION COPY (INITIAL): PINK OWNER COPY (INITIAL): GOLD