IREDELL COUNTY HEALTH DEPARTMENT

STATESVILLE 704-878-5305 MOORESVILLE 704-664-5281

IMPROVEMENT PERMIT / AUTHORIZATION TO CONSTRUCT / OPERATION PERMIT / EXISTING SYSTEM INSPECTION

PERMIT# 153431 PIN# 4784 78 19 76 DATE 11-10-08

OWNER OR APPLICANT Clayton Karen Cline PHONE: Business _____ Home 704-880 8360

ADDRESS 311 Barnhill RD Cleveland NC 27013

LOCATION 04E (FR) Barry Oak (RD) Barnhill (RD) at BOX 311

SUBDIVISION _____ BLOCK / SECTION _____ LOT _____ LOT AREA 4.09 AC SITE CLASS B DESIGN FLOW 360 L.T.A.R. Existing

Septic Tank: 1250/Exist Gallons: STB _____ Date _____

Pump Tank: _____ Gallons: PT _____ Date _____

Pump Make: _____ Model _____ Serial No. _____

Nitrification Field: No Fields ___ Square Feet 900 est Linear Feet 300/est

No Lines 3 Trench Width 36" Max Trench Bottom Depth 31"

☐ ~~New System~~ ☐ Repair ☐ Expansion System Type: I (II) III IV V VI

System Description: Gravel Conventional

Repair System Description: Gravel Conventional

Maintenance Agreement Required: ☐ Yes ☒ No

Gravel Depth 10 ☒ Gravity ☐ Pressure

☒ House/Mod. Home No. Bedrooms 3

☐ Mobile Home No. Persons ___

☐ Business No. Employees ___

☐ Other _____

Water Supply: ☐ Individual ☐ Public ☐ Community


☐ Slab ☐ Crawl Space ☒ Basement w/plumbing ☐ Basement wo/plumbing

Comments:/Conditions:

SD

Comments:/Conditions:

INITIAL SITE SKETCH

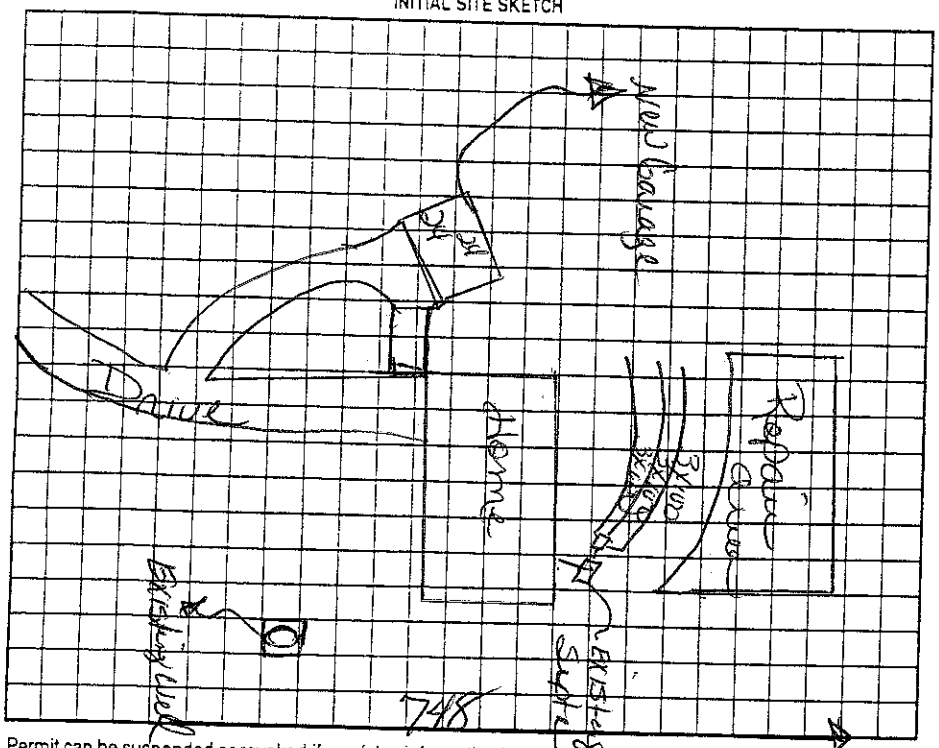

AS BUILT SKETCH

New Structure does not encroach septic system or repair

Keith Cook 11-10-08

311 Barnhill RD

Permit can be suspended or revoked if any false information is supplied toward securing the permit/any unauthorized changes are made to the site/any unauthorized changes are made in the installation of the system. Improvement Permit with plat valid without expiration ☐ Improvement Permit with site plan valid for sixty months ☐ Authorization to Construct is valid for a period equal to that of Improvement Permit – not to exceed sixty months.

Signed: Owner Was NOT Home date _____

Improvement Permit by: Keith Cook date 11-10-08

Authorization to Construct by: Keith Cook date 11-10-08

Installed by: System Unknown 1977

Operation Permit by: Keith Cook date 11-10-08

Existing System Inspection by: Keith Cook date 11-10-08

HEALTH DEPT. COPY: WHITE OWNER COPY (FINAL): YELLOW OWNER COPY (INITIAL): PINK