IREDELL COUNTY HEALTH DEPARTMENT

Statesville Office (704) 878-5305 Mooresville Office (704) 660-3625 PERMIT # 179943

IMPROVEMENT PERMIT / AUTHORIZATION TO CONSTRUCT / OPERATION PERMIT / EXISTING SYSTEM

PIN # 4785003559

APPLICANT: Joyce Summers APPLICANT ADDRESS: 179 Elmwood Rd.

SITE ADDRESS: 179 Elmwood Rd. PHONE: 704-872-8260 ALT. PHONE: N/A

SITE DIRECTIONS: Hwy 64 E TR Barry Oak Rd TR Elmwood Rd.

SUBDIVISION: N/A SECTION: N/A LOT # N/A LOT AREA: 1.52 acres DESIGN FLOW: 240 gpd L.T.A.R.: 0.25

Septic Tank Existing (gal) STB Date
Pump Tank (gal) PT Date
Pump Make Model Serial #
Nitrification Fields 1 # Lines 3 Linear Ft: 236
Trench Width 36" Max. Trench Bottom Depth 36" Gravel Depth N/A


☐ New System ☑ Repair ☐ Expansion System Type: I II III IV V VI
System Description:
Repair System Description: 25% Reduction
Maintenance Agreement Required: ☐ YES ☑ NO
☑ GRAVITY ☐ PRESSURE

☑ Residence No. Bedrooms 2
☐ Business No. Persons
☐ Other No. Employees
☐ Slab ☑ Crawl Space
☐ Basement w/plumbing ☐ Basement w/o plumbing


Water Supply
☑ Private
☐ Public
☐ Community

Comments / Conditions: Install a 25% Reduction System on Contour with serial distribution. Replace septic tank if needed.

INITIAL SITE SKETCH

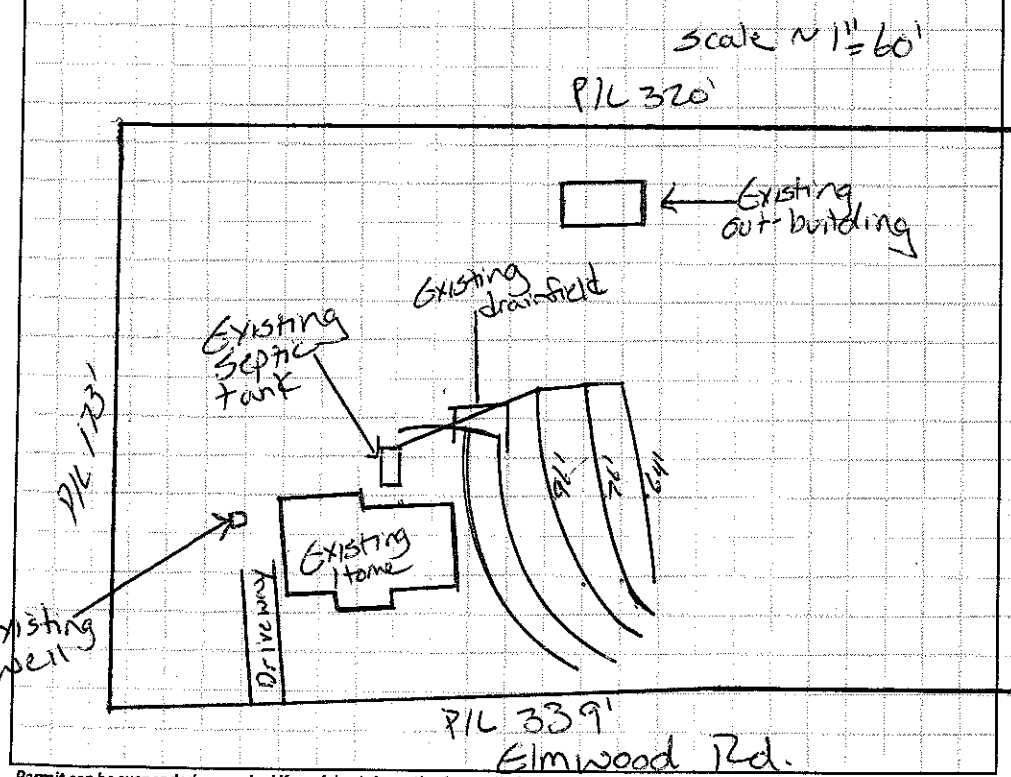

AS BUILT SKETCH

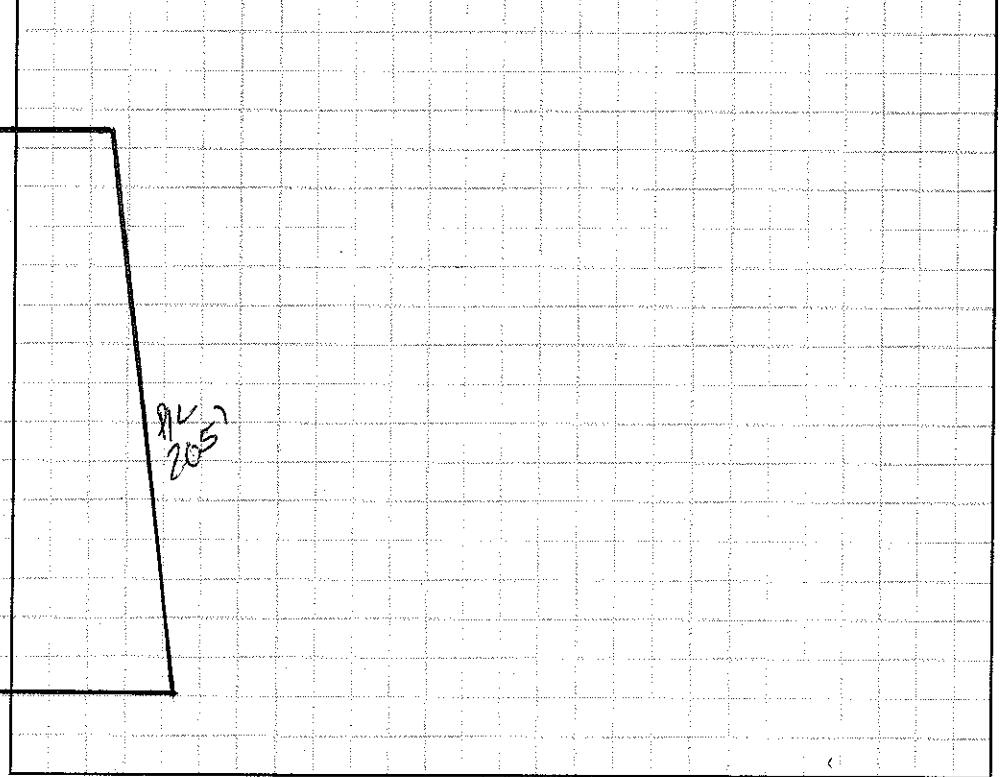

Permit can be suspended or revoked if any false information is supplied toward securing the permit / any unauthorized changes are made to the site / any unauthorized changes are made in the installation of the system. **CONTACT A LOCATOR SERVICE PRIOR TO ANY EXCAVATION**

☐ **IMPROVEMENT PERMIT** ***with plat*** *valid without expiration.* ☑ **IMPROVEMENT PERMIT** ***with site plan*** *valid for 60 mos.* ☑ **AUTHORIZATION TO CONSTRUCT** *valid for period equal to IMPROVEMENT PERMIT--not to exceed 60 mo.*

Owner / Applicant Signature: Joyce D Summers Date: 8-8-2013 Installed by: A-1 Backhoe

IMPROVEMENT PERMIT by: Justin Henderson Date: 8-7-13 OPERATION PERMIT by: James Date: 9-3-13

AUTHORIZATION TO CONSTRUCT by: Justin Henderson Date: 8-7-13 Existing System Inspected by: Date:

Health Dept. Copy - WHITE Applicant (Final Approval) - YELLOW Applicant (Conditional Approval) - PINK