IREDELL COUNTY HEALTH DEPARTMENT

STATESVILLE 704-878-5305 (C) MOORESVILLE 704-664-5281

IMPROVEMENT PERMIT / AUTHORIZATION TO CONSTRUCT / OPERATION PERMIT / EXISTING SYSTEM INSPECTION

PERMIT# 123153 PIN# 4785-00-~~5492.1~~ 6603 DATE 9-10-04

OWNER OR CONTRACTOR KEVIN ADKINS PHONE: Business 704-682-1435 Home 704-872-0946

ADDRESS 206 RUMLEY LANE, UNIT A STATESVILLE, NC 28625

LOCATION US 64 EAST, TR BARRY OAK ROAD, TR ELMWOOD ROAD, 0.4 MILE ON LEFT BACK OFF ROAD

SUBDIVISION _____ BLOCK / SECTION _____ LOT _____ LOT AREA 1.478 ACRES SITE CLASS. PS DESIGN FLOW 480 L.T.A.R. 0.25 GPD/FT²

Septic Tank: 1000 Gallons; STB 794 Date 9-26-04
Pump Tank: _____ Gallons; PT _____ Date _____
Pump Make: _____ Model _____ Serial No. _____
Nitrification Field: No Fields 1 Square Feet 1920 Linear Feet 640
No Lines SIX Trench Width 36" Max Trench Bottom Depth 36" Gravel Depth 12"

☑ New System ☐ Repair System Type: I, (II), III, IV, V, VI
System Description: CONVENTIONAL GRAVITY
Repair System Description: 25% REDUCTION, PUMP & GRAVITY
Maintenance Agreement Required: ☐ Yes ☑ No
☐ Slab ☑ Crawl Space ☐ Basement w/plumbing ☐ Basement wo/plumbing


☑ House/Mod. Home No. Bedrooms 4
☐ Mobile Home No. Bathrooms ____
☐ Business No. Employees ____
☐ Other _____

Water Supply: ☐ Individual ☑ Public ☐ Community


Comments:/Conditions: CONTACT HEALTH DEPARTMENT AFTER CLEARING & PRIOR TO INSTALLATION IN ORDER TO FLAG-OUT SYSTEM DRAINFIELD

Comments:/Conditions: SEPTIC TANK WITH MARKER INSTALLED USING "POLYLOK" RED FILTER

INITIAL SITE SKETCH SCALE: 1" = 50'

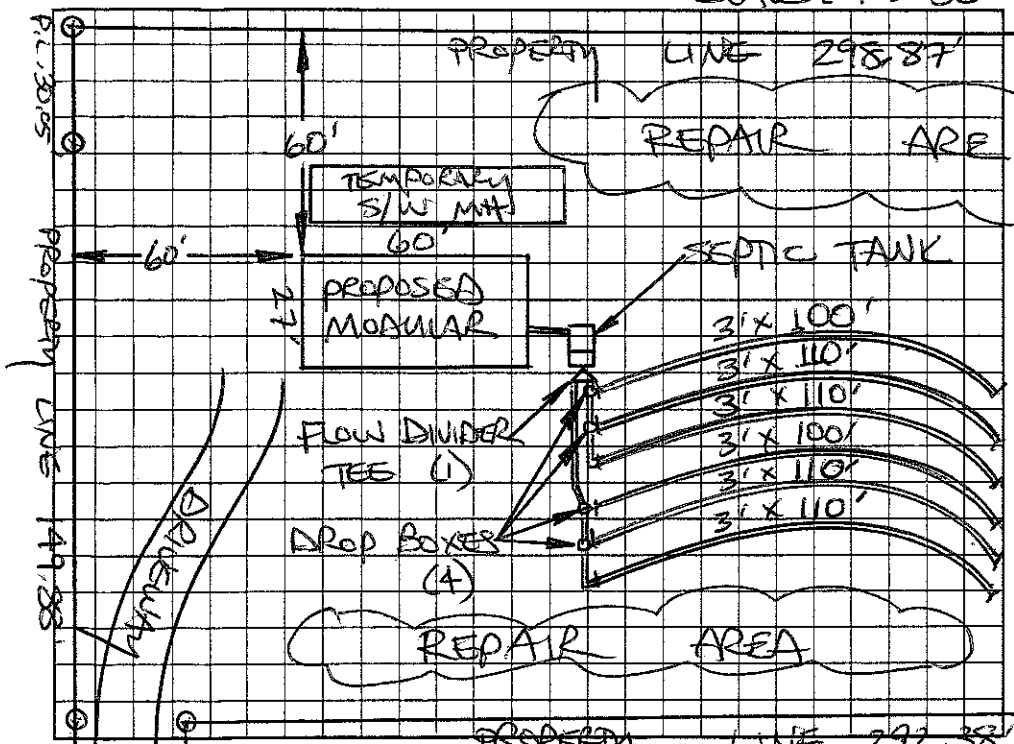

AS BUILT SKETCH

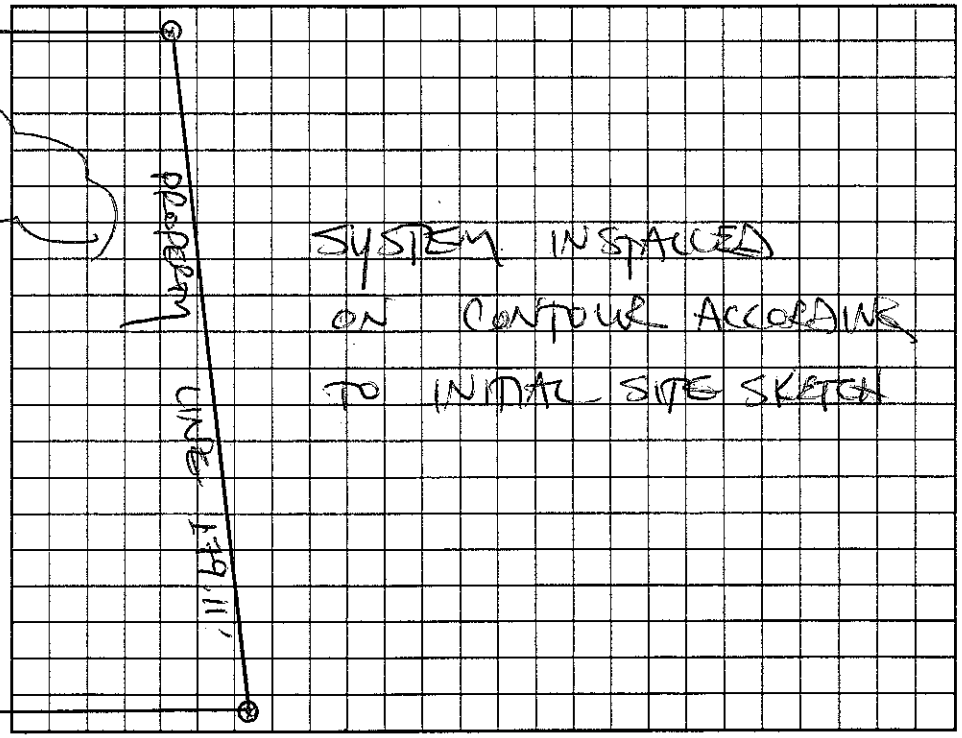

Permit can be suspended or revoked if any false information is supplied toward securing the permit/any unauthorized changes are made to the site/any unauthorized changes are made in the installation of the system. Improvement Permit with plat valid without expiration. Improvement Permit with site plan valid for sixty months. Authorization to Construct is valid for a period equal to that of Improvement Permit – not to exceed sixty months.

Signed: x Kevin B. Adkins date 9-10-04

Improvement Permit by: STEVE HEDRICK date 9-10-04

Authorization to Construct by: STEVE HEDRICK date 9-10-04

Installed by: SPECIALTY SEPTIC

Operation Permit by: STEVE HEDRICK date 12-15-04

Existing System Inspection by: _____ date _____

HEALTH DEPT. COPY: WHITE OWNER COPY (FINAL): YELLOW OWNER COPY (INITIAL): PINK