IREDELL COUNTY HEALTH DEPARTMENT STATESVILLE 704-878-5305 MOORESVILLE 704-664-5281

IMPROVEMENT PERMIT / AUTHORIZATION TO CONSTRUCT / OPERATION PERMIT / EXISTING SYSTEM INSPECTION

PERMIT # Repair PIN # 4785 01 2774 DATE 5-29-09

OWNER or APPLICANT Tommy Wiley PHONE: Business 704-761-9760 Home: 704-880-2452

OWNER or APPLICANT ADDRESS 131 Elmwood Rd Statesville 28625

LOCATION / DIRECTIONS 64 E (TL) Barry Oak (TR) Elmwood on left

SUBDIVISION BLOCK / SECTION LOT # LOT AREA DESIGN FLOW 240 L.T.A.R. Exst

Septic Tank Exst Gallons: STB Date

Pump Tank Gallons: PT Date

Pump Make Model Serial #

Nitrification Field No Fields No Lines Linear Feet

Trench Width Exst Max. Trench Bottom Depth Exst Gravel Depth Exist ☑ GRAVITY ☐ PRESSURE

☐ New System (Existing) ☑ Repair ☐ Expansion System Type (I) II III IV V VI

System Description: Existing Gravel

Repair System Description:

Maintenance Agreement Required ☐ YES ☐ NO

☑ Residence No. Bedrooms 2

☐ Business No. Persons

☐ Other No. Employees

☐ Slab ☑ Crawl Space


☐ Basement w/plumbing ☐ Basement w/o plumbing

Water Supply ☑ Private ☐ Public ☐ Community

Comments / Conditions

Comments / Conditions

INITIAL SITE SKETCH

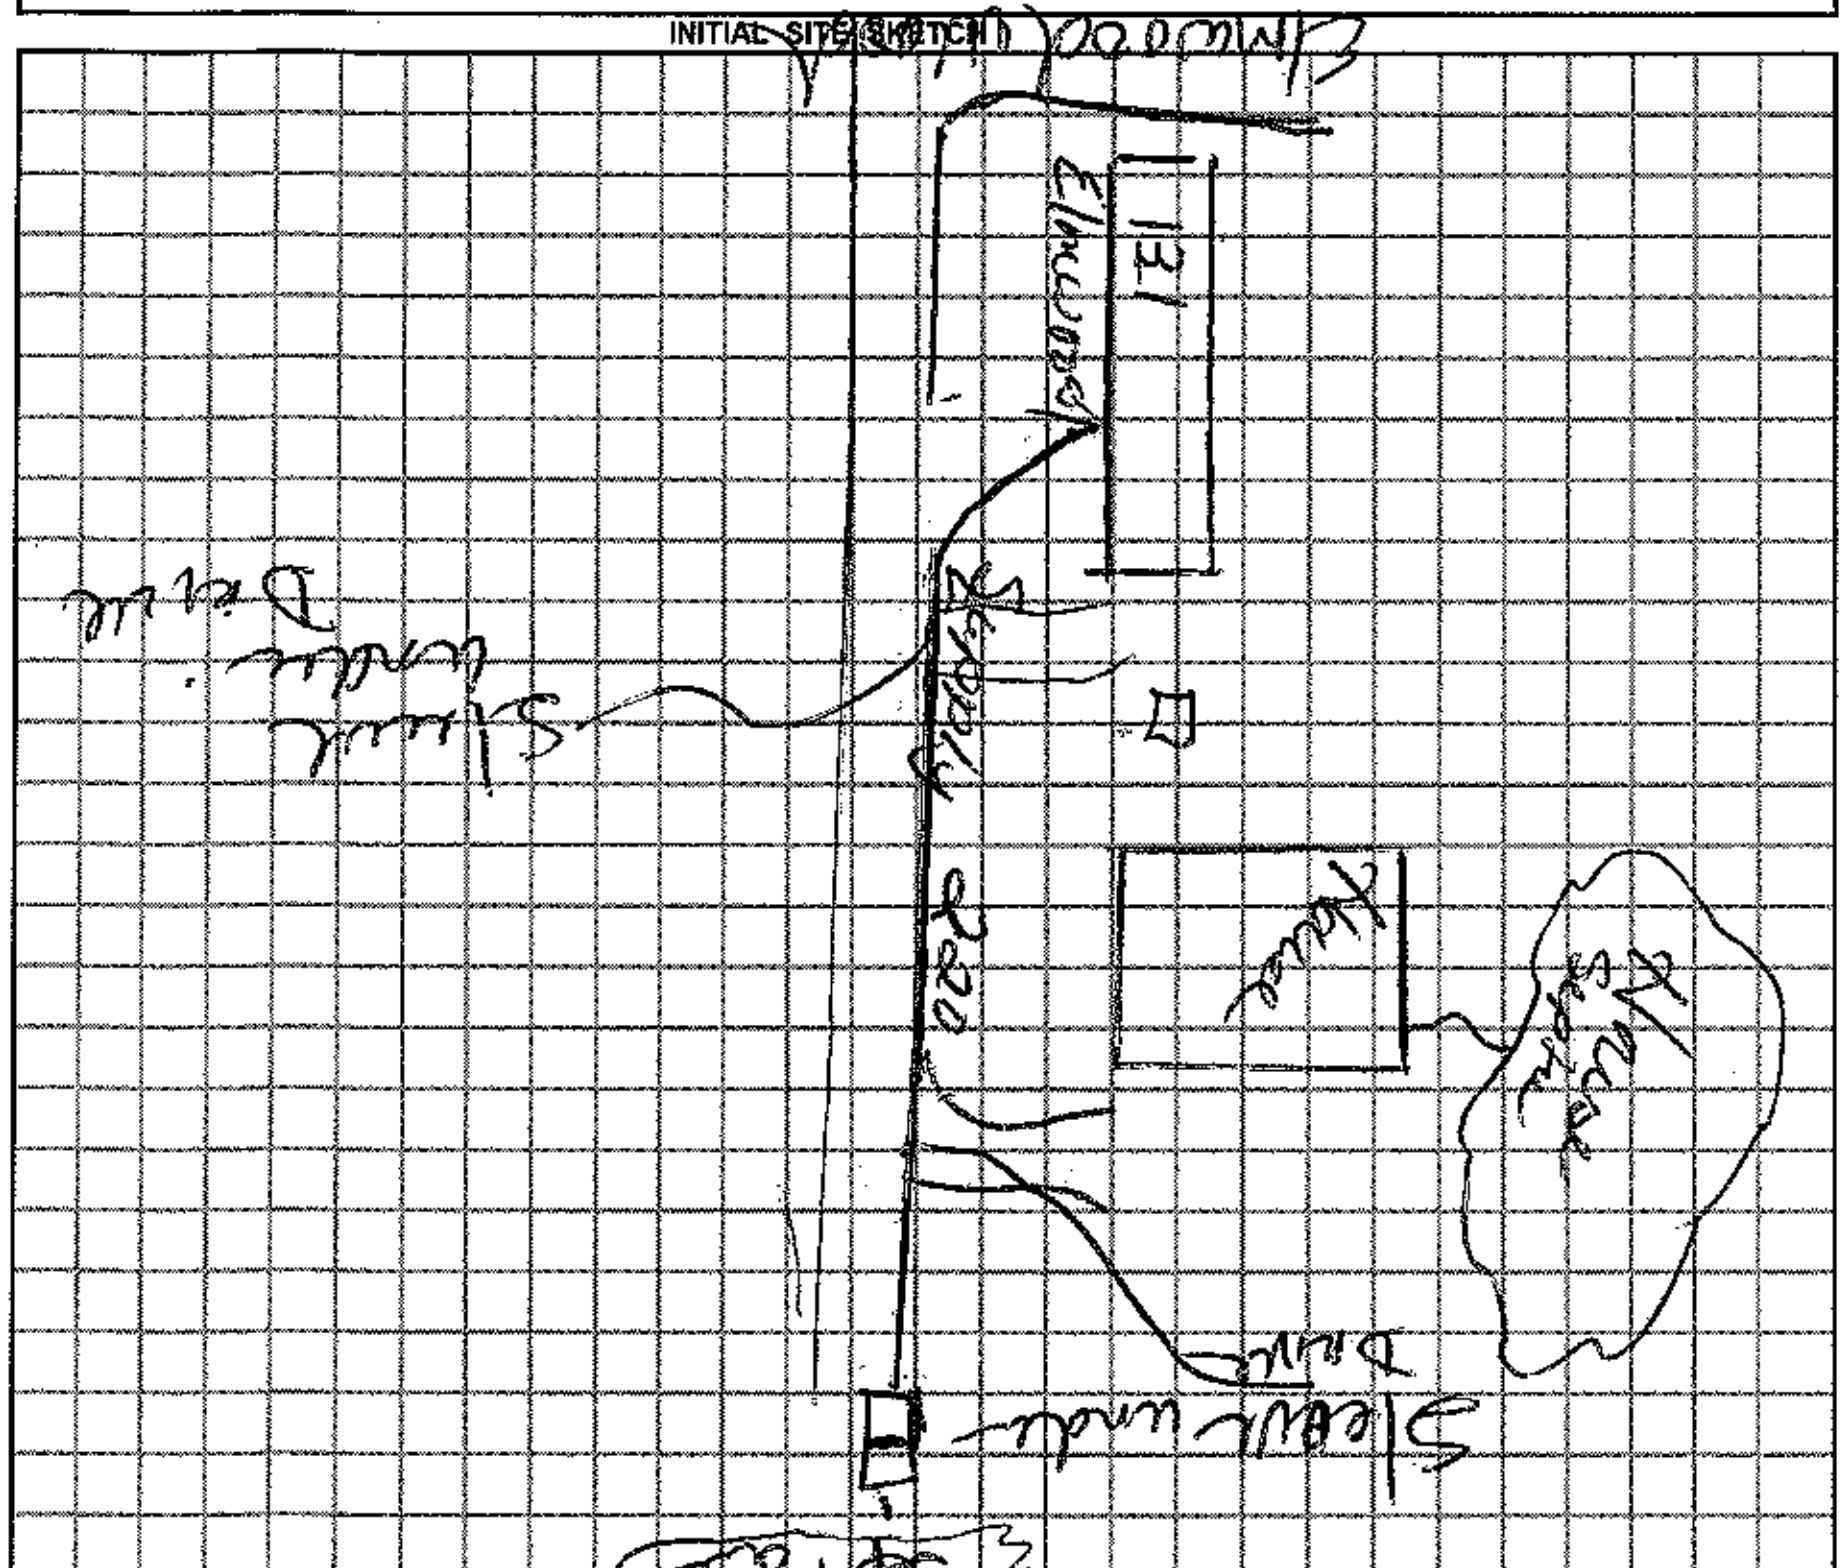

AS BUILT SKETCH

Permit can be suspended or revoked if any false information is supplied toward securing the permit / any unauthorized changes are made to the site / any unauthorized changes are made in the installation of the system.

☐ IMPROVEMENT PERMIT w / plat valid without expiration. ☐ IMPROVEMENT PERMIT w / site plan valid for 60 mos. ☑ AUTHORIZATION TO CONSTRUCT valid for period equal to IMPROVEMENT PERMIT-not to exceed 60 mo.

Owner / Applicant Signature Tommy Wiley Date

Improvement Permit by: Kelly Cook Date 5-29-09

Authorzation to Construct by: Kelly Cook Date 5-29-09

YOU SHOULD CONTACT A LOCATOR SERVICE PRIOR TO ANY EXCAVATION.

Installed by:

Operation Permit by: Date: 5-29-09

Existing System Inspected by: Kelly Cook Date:

WHITE COPY Environmental Health YELLOW COPY (Final) Owner / Applicant PINK COPY (Initial) Owner / Applicant