3:30

IREDELL COUNTY HEALTH DEPARTMENT

STATESVILLE 704-878-5305 MOORESVILLE 704-664-5281

IMPROVEMENT PERMIT / AUTHORIZATION TO CONSTRUCT / OPERATION PERMIT / EXISTING SYSTEM INSPECTION

PERMIT# 91530 PIN# 4785012804

OWNER OR CONTRACTOR Steven Akers DATE 8-29-00

ADDRESS PO Box 106 Statesville, N.C. PHONE: Business Home 704 278 3649

LOCATION 64E TR Barry oak TR Elmwood 500' on left.

SUBDIVISION BLOCK / SECTION LOT LOT AREA 1.14acre SITE CLASS PS DESIGN FLOW 480 L.T.A.R. .33

Septic Tank: 1000 Gallons; STB 312 Date 6/5/00

Pump Tank: Gallons; PT Date

Pump Make: Model Serial No.

Nitrification Field: No Fields 1 Square Feet 1440 Linear Feet 480

No Lines 6 Trench Width 36" Max Trench Bottom Depth 36" Gravel Depth 12"

☑ New System ☐ Repair System Type: (II) III, IV, V, VI

System Description: Conv. Gravity

Repair System Description: Gravity 25% Reduct.

Maintenance Agreement Required: ☐ Yes ☑ No

☐ Slab ☑ Crawl Space ☐ Basement w/plumbing ☐ Basement wo/plumbing

☐ House/Mod. Home ☑ Mobile Home ☐ Business ☐ Other


No. Bedrooms 4 No. Bathrooms 2 No. Employees

Water Supply: ☐ Individual ☑ Public ☐ Community

Comments:/Conditions:

Comments:/Conditions:

INITIAL SITE SKETCH AS BUILT SKETCH

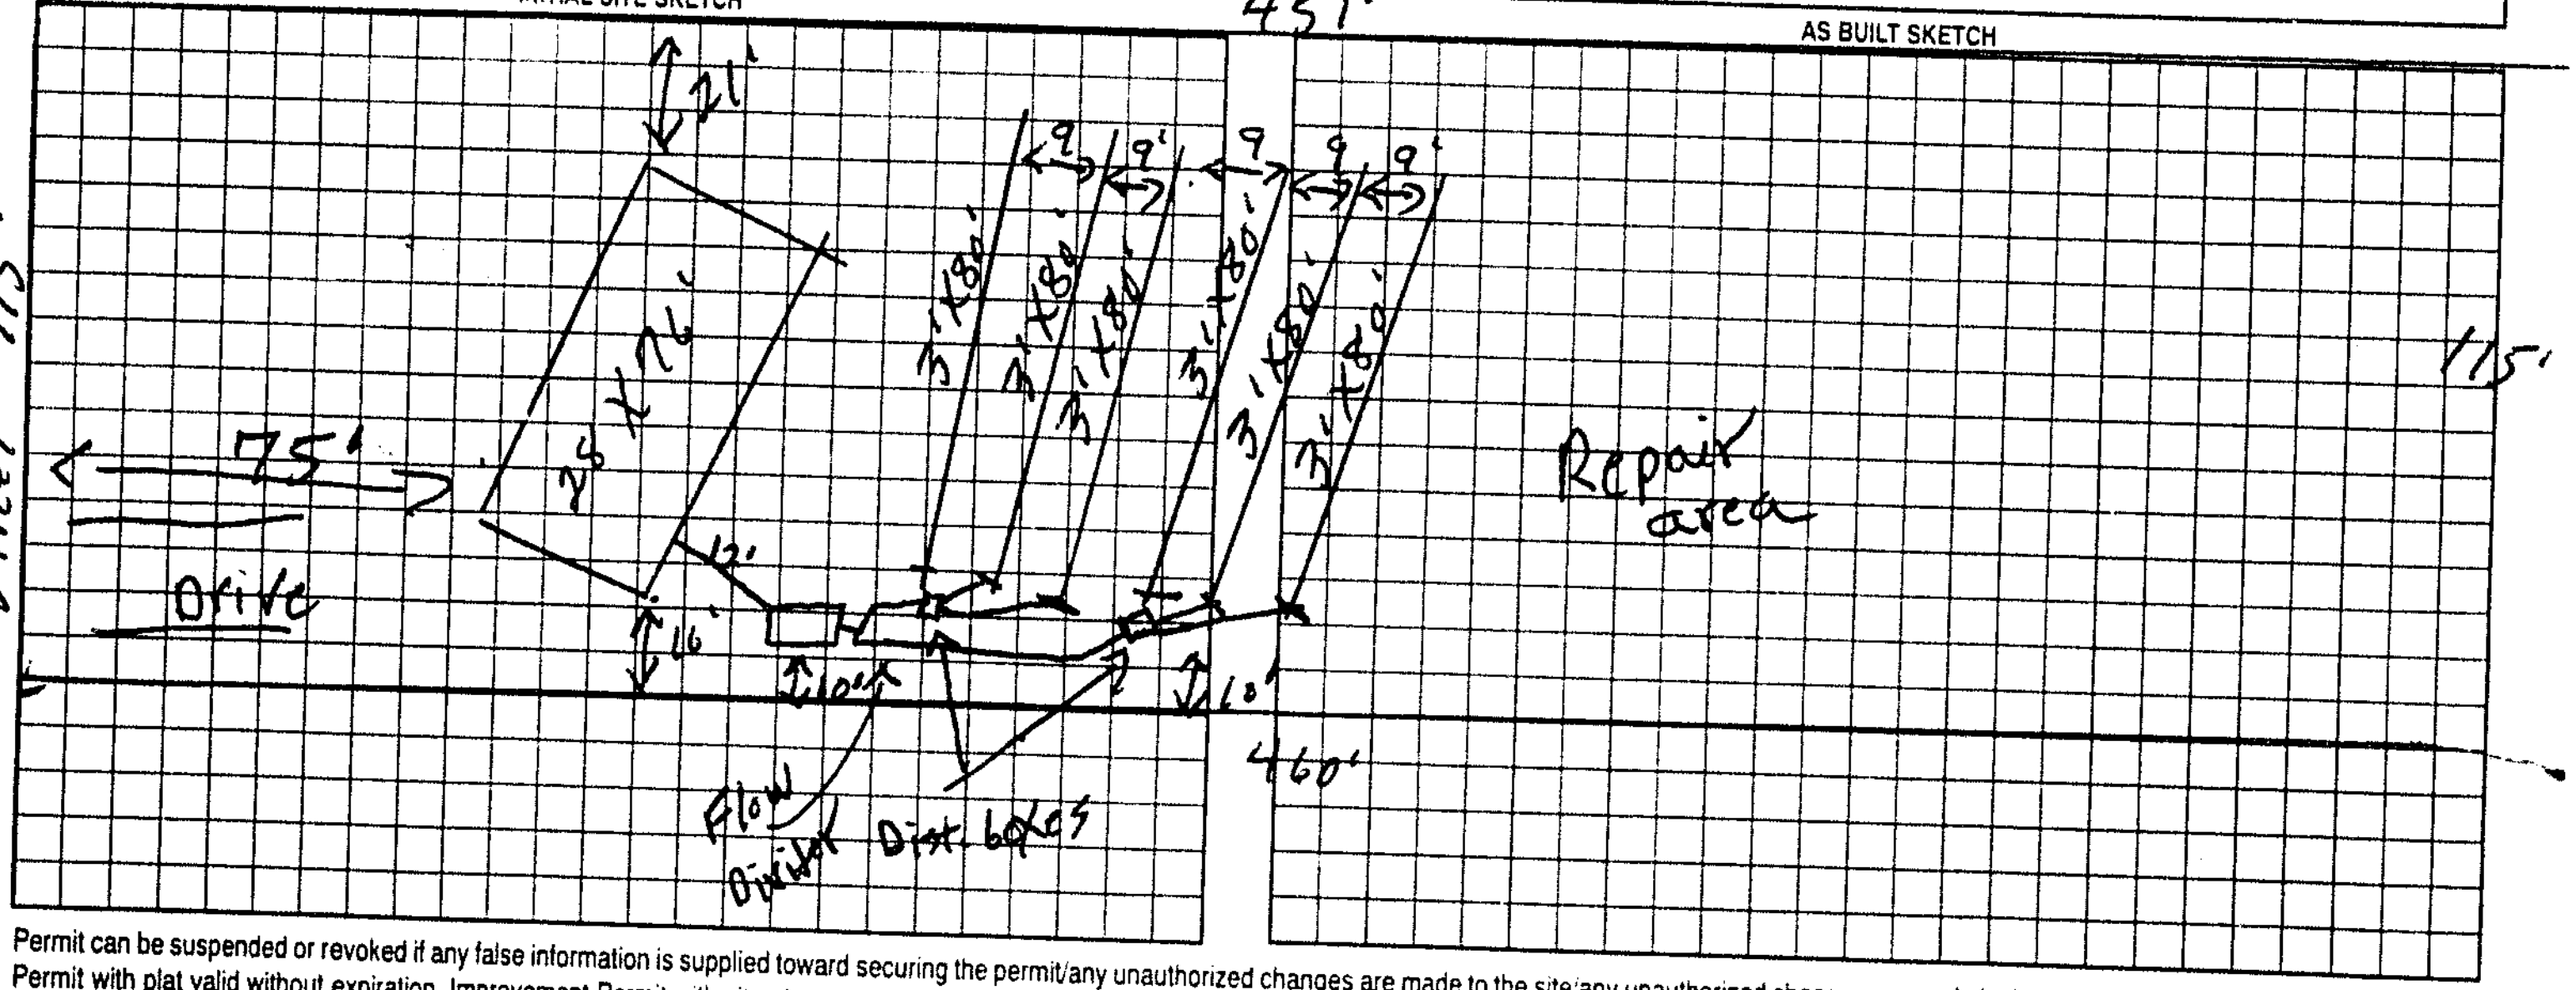

Permit can be suspended or revoked if any false information is supplied toward securing the permit/any unauthorized changes are made to the site/any unauthorized changes are made in the installation of the system. Improvement Permit with plat valid without expiration. Improvement Permit with site plan valid for sixty months. Authorization to Construct is valid for a period equal to that of Improvement Permit – not to exceed sixty months.

Signed: X Jane Akers date 8/29/00 Installed by: Craig Thompson

Improvement Permit by: R. C. Moore date 8-29-00 Operation Permit by: [signature] RSI date 10/13/00

Authorization to Construct by: R. C. Moore date 8-29-00 Existing System Inspection by: date

HEALTH DEPT COPY WHITE OWNER COPY (FINAL) YELLOW OWNER COPY (INITIAL) PINK