# IREDELL COUNTY HEALTH DEPARTMENT

Statesville Office (704) 878-5305 Mooresville Office (704) 660-3625 PERMIT # 203255

## IMPROVEMENT PERMIT / AUTHORIZATION TO CONSTRUCT / OPERATION PERMIT / EXISTING SYSTEM

PIN # 4785118602

APPLICANT: Robert Lee Marlow APPLICANT ADDRESS: [redacted] 482 Barry Oak Rd Statesville NC

SITE ADDRESS: 121 Marlow Woods Ln Statesville NC 28625 PHONE: 704-902-1673 ALT. PHONE: N/A

SITE DIRECTIONS: Hwy 64E T/R Barry Oak Rd Past Faith Baptist Church 3rd Driveway on right


SUBDIVISION: N/A SECTION: N/A LOT # N/A LOT AREA: 2.0 ac DESIGN FLOW: 240 L.T.A.R.: 0.25

| | | | | | | | | | | | |
|---|---|---|---|---|---|---|---|---|---|---|---|
| Septic Tank | 1000 (gal) | STB | 10/2 | Date | 3-2-15 | ☑ New System | ☐ Repair | ☐ Expansion | System Type: I II ☒ III IV V VI | ☒ Residence | No. Bedrooms 2 |
| Pump Tank | N/A (gal) | PT | N/A | Date | N/A | System Description: | 25% Reduction | | | ☐ Business | No. Persons 4 |
| Pump Make | N/A | Model | Jetstream | Serial # | EF-4 | Repair System Description: | 25% Reduction | | | ☐ Other | No. Employees |
| # Nitrification Fields | 1 | # Lines | 2 | Linear Ft: | 240 | Maintenance Agreement Required: | ☐ YES | ☑ NO | | ☐ Slab | ☑ Crawl Space |
| Trench Width | 36" | Max. Trench Bottom Depth | 36" | Gravel Depth | N/A | | ☑ GRAVITY | ☐ PRESSURE | | ☐ Basement w/plumbing | ☐ Basement w/o plumbing |


Water Supply: ☐ Private ☒ Public ☐ Community

Comments / Conditions: Install 25% reduction on Contour with Serial distribution.

INITIAL SITE SKETCH

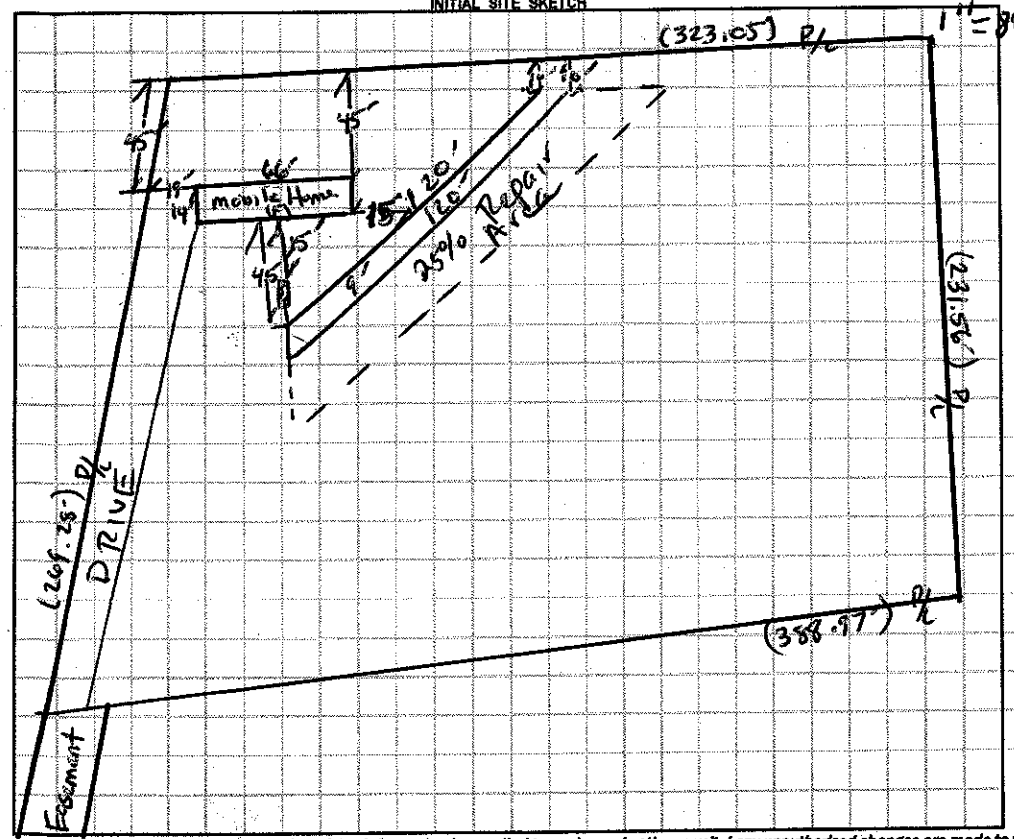


AS BUILT SKETCH

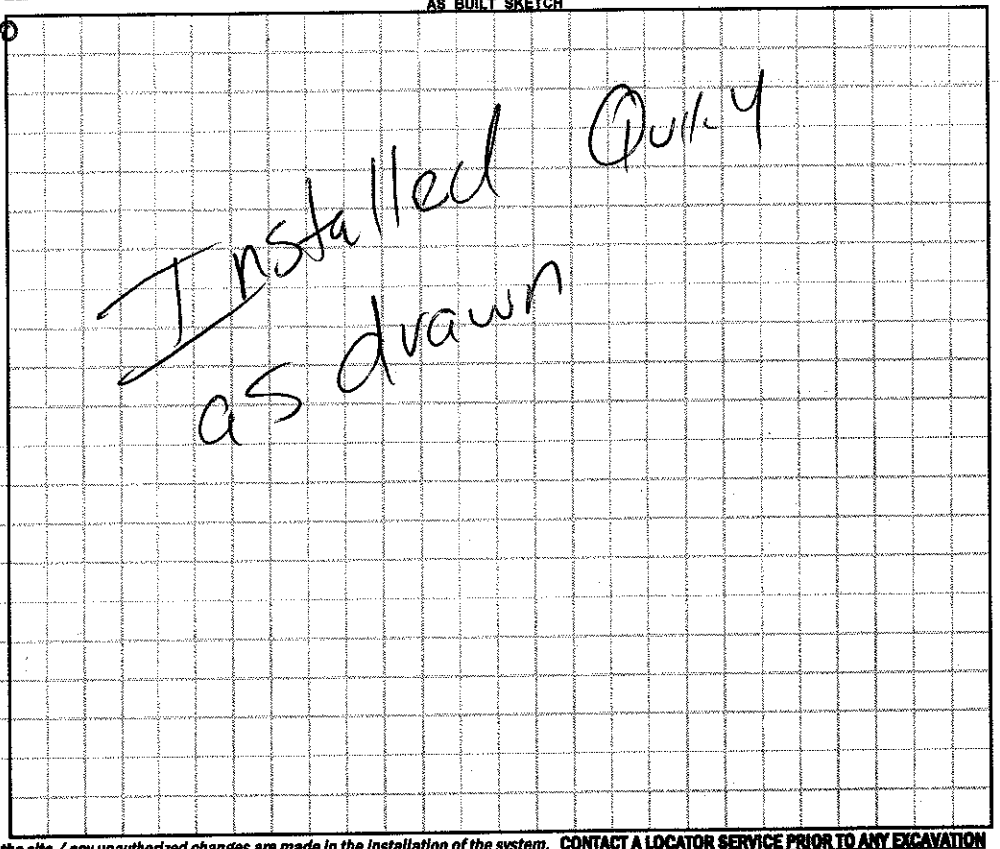


*Permit can be suspended or revoked if any false information is supplied toward securing the permit / any unauthorized changes are made to the site / any unauthorized changes are made in the installation of the system.* **CONTACT A LOCATOR SERVICE PRIOR TO ANY EXCAVATION**

☐ **IMPROVEMENT PERMIT** *with plat valid without expiration* ☑ **IMPROVEMENT PERMIT** *with site plan valid for 60 mos.* ☑ **AUTHORIZATION TO CONSTRUCT** *valid for period equal to IMPROVEMENT PERMIT--not to exceed 60 mo.*

Owner / Applicant Signature: Lee Marlow Date: 08/21/15 Installed by: Steve Jordan

IMPROVEMENT PERMIT by: Robert H Jordan Date: 08/17/15 OPERATION PERMIT by: Robert H Jordan Date: 10/23/15

AUTHORIZATION TO CONSTRUCT by: Robert H Jordan Date: 08/17/15 Existing System Inspected by: Date:

Health Dept. Copy - WHITE Applicant (Final Approval) - YELLOW Applicant (Conditional Approval) - PINK