IREDELL COUNTY HEALTH DEPARTMENT

Statesville Office (704) 878-5305 Mooresville Office (704) 660-3625 PERMIT # 201583

IMPROVEMENT PERMIT / AUTHORIZATION TO CONSTRUCT / OPERATION PERMIT / EXISTING SYSTEM

PIN # 4785120878

APPLICANT: Al Gingerich APPLICANT ADDRESS: 445 Airpark Dr Mooresville NC

SITE ADDRESS: 501 Barry Oak Rd Statesville NC 28625 PHONE: 704-662-8628 ALT. PHONE: N/A

SITE DIRECTIONS: 64E T/R Barry Oak Rd 1mile on Left

SUBDIVISION: N/A SECTION: N/A LOT # N/A LOT AREA: 4ac DESIGN FLOW: 360 L.T.A.R.: .3


Septic Tank	1000 (gal)	STB	825	Date	8-1-14	[X] New System	[ ] Repair	[ ] Expansion	System Type: I II (III) IV V VI
Pump Tank	N/A (gal)	PT	N/A	Date	N/A	System Description:	25% Reduction		
Pump Make	N/A	Model	Infiltrator	Serial #		Repair System Description:	25% Reduction		
# Nitrification Fields	1	# Lines	4	Linear Ft:	300	Maintenance Agreement Required:	[ ] YES	[X] NO	
Trench Width	36"	Max. Trench Bottom Depth	36"	Gravel Depth	N/A	[X] GRAVITY	[ ] PRESSURE		

[X] Residence No. Bedrooms 3
[ ] Business No. Persons 6
[ ] Other No. Employees
[ ] Slab [ ] Crawl Space
[ ] Basement w/plumbing [X] Basement w/o plumbing


Water Supply: [X] Private [ ] Public [ ] Community

Comments / Conditions: * Improvements Permit only * must submit new plat and floor plan. Install 25% Reduction on contour with Serial distribution

INITIAL SITE SKETCH

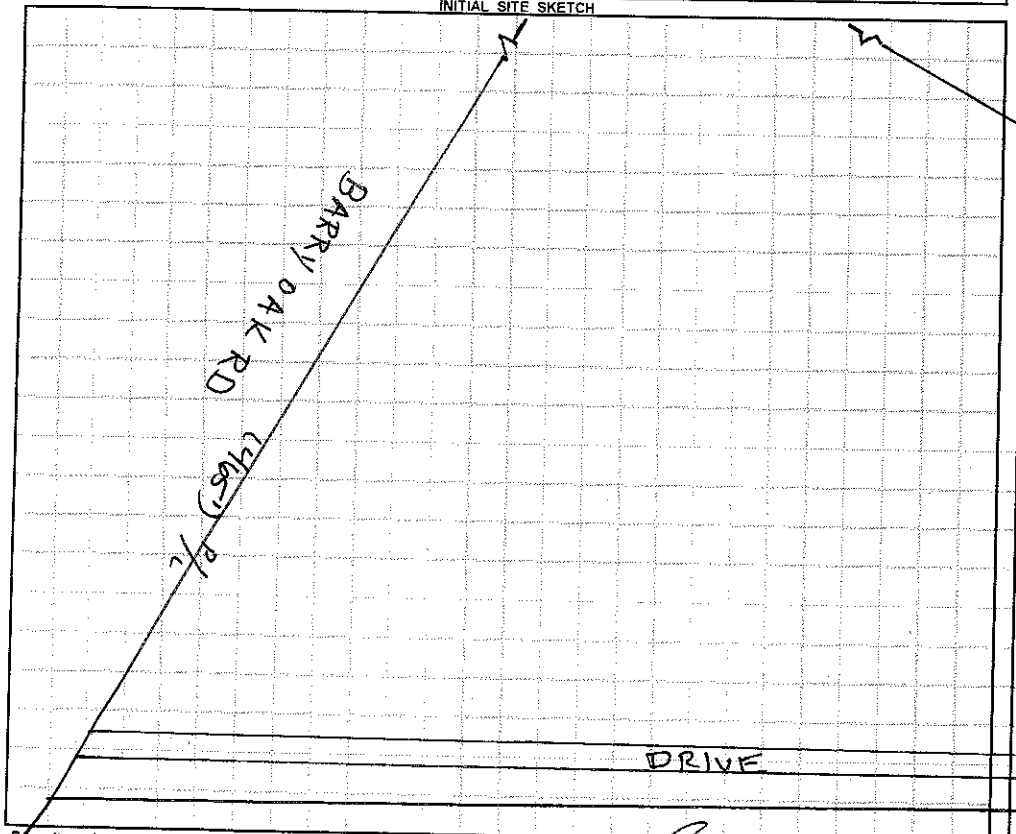

AS BUILT SKETCH

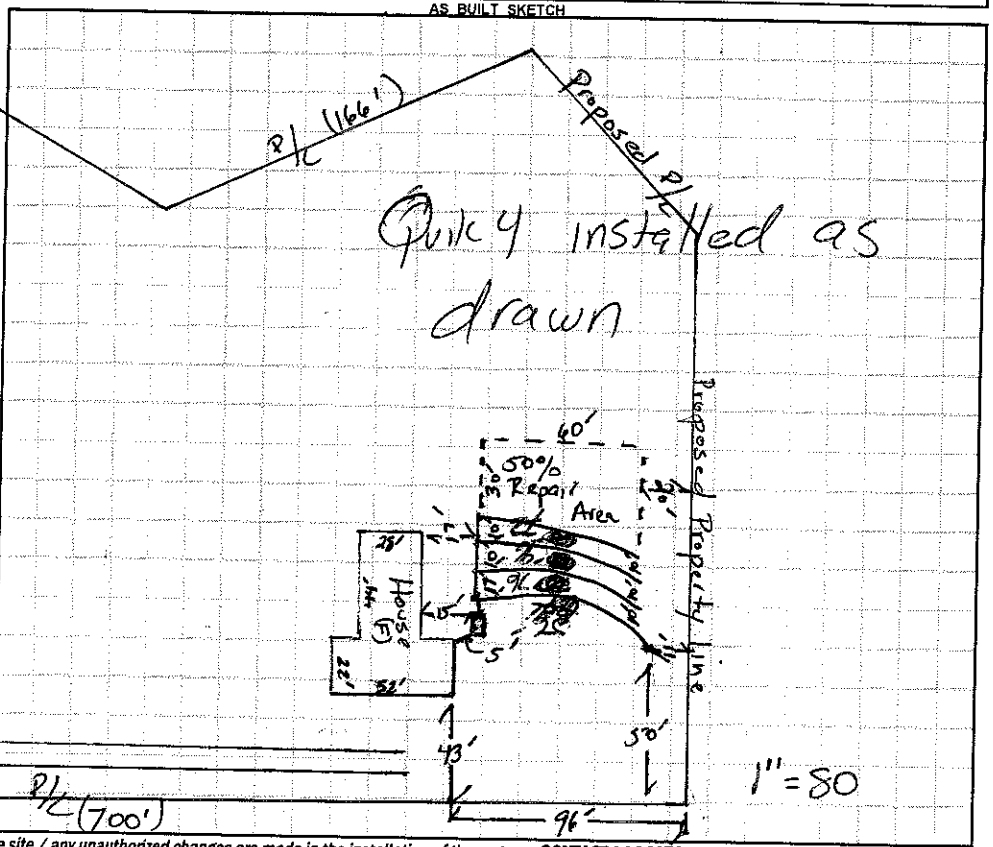

Permit can be suspended or revoked if any false information is supplied toward securing the permit / any unauthorized changes are made to the site / any unauthorized changes are made in the installation of the system. **CONTACT A LOCATOR SERVICE PRIOR TO ANY EXCAVATION**

[ ] **IMPROVEMENT PERMIT** *with plat valid without expiration.* [X] **IMPROVEMENT PERMIT** *with site plan valid for 60 mos.* [X] **AUTHORIZATION TO CONSTRUCT** *valid for period equal to IMPROVEMENT PERMIT--not to exceed 60 mo.*

Owner / Applicant Signature: Date: 4/1/14 Installed by: Rowan Septic

IMPROVEMENT PERMIT by: Date: 02/27/14 OPERATION PERMIT by: Date: 09/16/14

AUTHORIZATION TO CONSTRUCT by: Date: 04/03/14 Existing System Inspected by: Date:

Health Dept. Copy - WHITE Applicant (Final Approval) - YELLOW Applicant (Conditional Approval) - PINK