IREDELL COUNTY HEALTH DEPARTMENT

STATESVILLE 704-878-5305 MOORESVILLE 704-664-5281

IMPROVEMENT PERMIT / AUTHORIZATION TO CONSTRUCT / OPERATION PERMIT / EXISTING SYSTEM INSPECTION

PERMIT# 95029 PIN# 4785 19 9122

OWNER OR CONTRACTOR JOEL TURPIN DATE 3-7-01

ADDRESS 157 Peninsula Dr, MOORESVILLE, NC 28117 PHONE: Business 363-3923 Home 664-3609

LOCATION HWY 64 E, @ IN FRONT OF FIFTH CREEK PRESBYTERIAN CHURCH, WAY OF ROAD

SUBDIVISION _____ BLOCK / SECTION _____ LOT _____ LOT AREA 31 ACRES SITE CLASS PS DESIGN FLOW 360 L.T.A.R. .3

Septic Tank: 1000 Gallons; STB 1012 Date 2-12-01
Pump Tank: _____ Gallons; PT _____ Date _____
Pump Make: _____ Model _____ Serial No. _____
Nitrification Field: No Fields 1 Square Feet 1200' Linear Feet 400'
No Lines 4 Trench Width 36" Max Trench Bottom Depth 36"

X New System ☐ Repair System Type: I. II. III. IV. V. VI
System Description: CONV GRAV
Repair System Description: PUMP/GRAV - 254 LF EQ
Maintenance Agreement Required: ☐ Yes X No
Gravel Depth 12"


X House/Mod. Home No. Bedrooms 3
☐ Mobile Home No. Bathrooms 2
☐ Business No. Employees ____
☐ Other _____
☐ Slab X Crawl Space ☐ Basement w/plumbing ☐ Basement wo/plumbing

Water Supply: X Individual ☐ Public ☐ Community WELL

Comments/Conditions: ① KEEP FRENCH DRAIN 10' ABOVE SYSTEM & 15' to the side of system & install at least 48" deep or deeper. ② INSTALL LINES ON CONTOUR ③ KEEP SYSTEM 50' off CREEK, 10' off property lines & 5' off house

Comments/Conditions: ④ Crush & Fill in old tank ⑤ TAKE PROPER PROCEDURES FOR WELL ABANDONMENT ⑥ KEEP WELL 100' FROM ANY PART OF SYSTEM ⑦ It would be best if FRENCH DRAIN WAS ATLEAST 20' or greater away from the side of system to possible bleeding from the drain lines into the FRENCH DRAIN. ANY QUESTIONS CALL 928-2030.

INITIAL SITE SKETCH

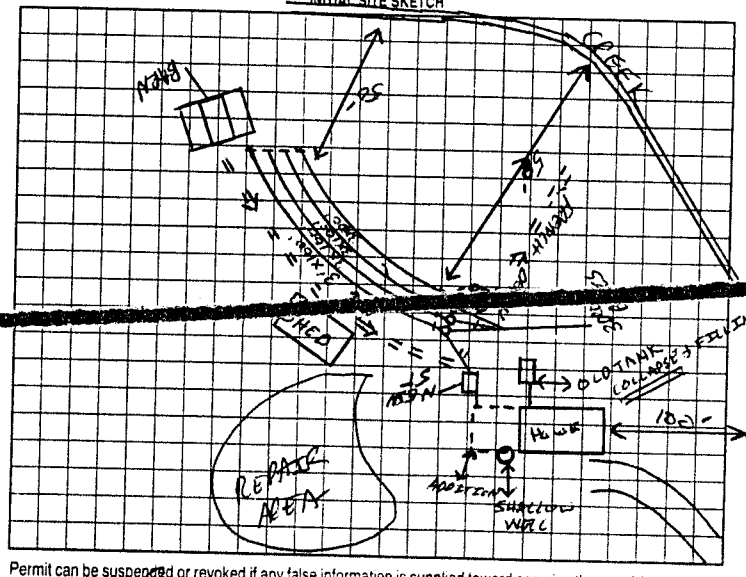

AS BUILT SKETCH

SYSTEM INSTALLED AS SHOWN WITH POLYLOK FILTER & MARKER

Permit can be suspended or revoked if any false information is supplied toward securing the permit/any unauthorized changes are made to the site/any unauthorized changes are made in the installation of the system. Improvement Permit with plat valid without expiration. Improvement Permit with site plan valid for sixty months. Authorization to Construct is valid for a period equal to that of Improvement Permit – not to exceed sixty months.

Signed: Joel Turpin date 3/22/01 Installed by: A-1 BACKHOE

Improvement Permit by: John Cook RSI date 03.07.01 Operation Permit by: John Cook RSI date 4-23-01

Authorization to Construct by: John Cook RSI date 03.07.01 Existing System Inspection by: _____ date _____

HEALTH DEPT COPY WHITE OWNER COPY (FINAL) YELLOW OWNER COPY (INITIAL) PINK