IREDELL COUNTY HEALTH DEPARTMENT

STATESVILLE 704-878-5305 MOORESVILLE 704-664-5281

IMPROVEMENT PERMIT / AUTHORIZATION TO CONSTRUCT / OPERATION PERMIT / EXISTING SYSTEM INSPECTION

PERMIT# 129060 PIN# 4785213683 DATE 7-20-05

OWNER OR CONTRACTOR John Allen PHONE: Business 704-278-9834 Home

ADDRESS 404 3rd creek church Rd, Cleveland 27013

LOCATION 64 E, TR Barry Oak Rd., 3 to 4 mi. on right

SUBDIVISION BLOCK / SECTION LOT LOT AREA .838 ac SITE CLASS. PS DESIGN FLOW 360 L.T.A.R. .125

Septic Tank: 1000 Gallons: STB RST-828 Date 8-30-05
Pump Tank: Gallons; PT Date
Pump Make: Model Serial No.
Nitrification Field: No Fields Square Feet 1440 Linear Feet 480
No Lines 6 Trench Width 36" Max Trench Bottom Depth 36" Gravel Depth 12"

☒ New System ☐ Repair System Type: I ☐ II, III, IV, V, VI
System Description: conv. gravity
Repair System Description: 25% reduction
Maintenance Agreement Required: ☐ Yes ☒ No

☒ House/Mod. Home No. Bedrooms 3
☐ Mobile Home No. Bathrooms
☐ Business No. Employees
☐ Other

☐ Slab ☒ Crawl Space ☐ Basement w/plumbing ☐ Basement wo/plumbing

Water Supply: ☐ Individual ☒ Public ☒ Community

Comments:/Conditions:


max. trench depth 36"
3 - center fed trenches 95' each

Comments:/Conditions:

Blue Poly Inlet Filter installed

1" = 60'

INITIAL SITE SKETCH

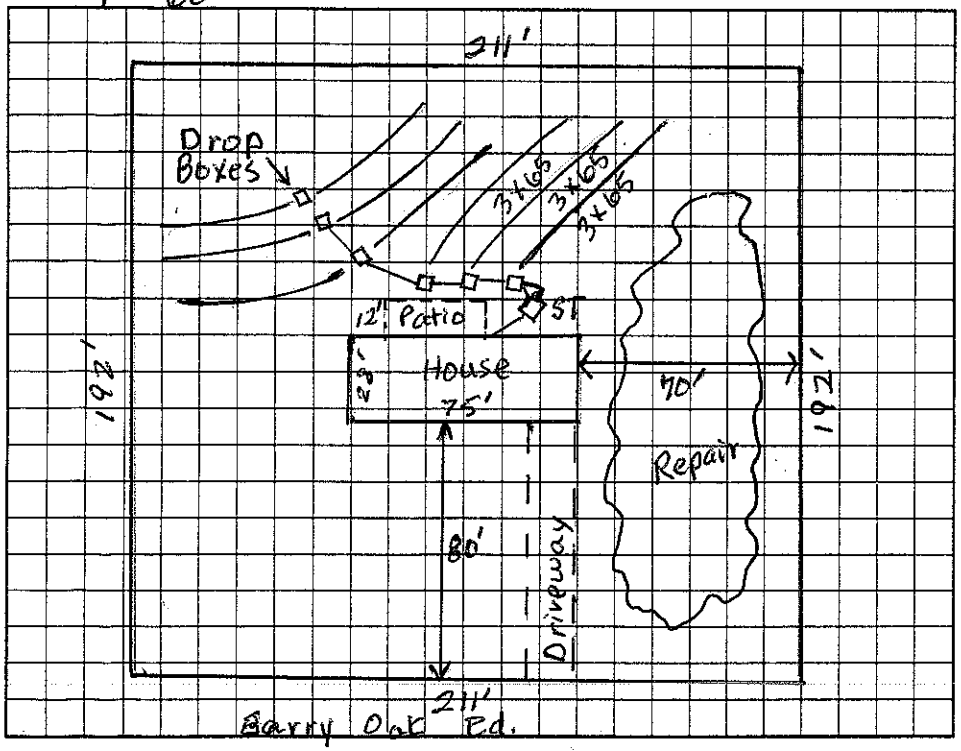

AS BUILT SKETCH

Permit can be suspended or revoked if any false information is supplied toward securing the permit/any unauthorized changes are made to the site/any unauthorized changes are made in the installation of the system. Improvement Permit with plat valid without expiration. Improvement Permit with site plan valid for sixty months. Authorization to Construct is valid for a period equal to that of Improvement Permit – not to exceed sixty months.

Signed: John C. Allen, Jr. date 7-21-05 Installed by: Rowan Septic

Improvement Permit by: Judy Melville date 7-20-05 Operation Permit by: Kelly Cox date 12-13-05

Authorization to Construct by: Judy Melville date 7-20-05 Existing System Inspection by: date

HEALTH DEPT. COPY: WHITE OWNER COPY (FINAL): YELLOW OWNER COPY (INITIAL): PINK