IREDELL COUNTY HEALTH DEPARTMENT

4785 22 1636

STATESVILLE 704-878-5305

871 2351

MOORESVILLE 704-664-5281

IMPROVEMENT PERMIT / AUTHORIZATION TO CONSTRUCT / OPERATION PERMIT / EXISTING SYSTEM INSPECTION

PERMIT# 132692 PIN# ~~4785-22-0599~~ 4785221636 DATE 9-24-08

OWNER OR APPLICANT Abram J. Taylor PHONE: Business 704-664-9316 Home

ADDRESS 105 Cloud Top Lane Mooresville NC 28115

LOCATION 505 Barry Oak Road

SUBDIVISION BLOCK / SECTION LOT LOT AREA 2. 1AC SITE CLASS B DESIGN FLOW 480 L.T.A.R. .25

Septic Tank: 1000 Gallons: STB 825 Date 10-29-12

Pump Tank: Gallons: PT Date

Pump Make: Model Serial No.

Nitrification Field: No Fields Square Feet 1920 Linear Feet 480

No Lines 5 Trench Width 24" Max Trench Bottom Depth 36" Gravel Depth ☐ Gravity ☐ Pressure

☑ New System ☐ Repair ☐ Expansion System Type: I II III IV V VI

System Description: 25% Reduction

Repair System Description: 25% Reduction 2 LTAR

Maintenance Agreement Required: ☐ Yes ☑ No

☑ House/Mod. Home ☐ Mobile Home ☐ Business ☐ Other

No. Bedrooms 4 No. Persons No. Employees

Water Supply: ☑ Individual ☐ Public ☐ Community

☐ Slab ☑ Crawl Space ☐ Basement w/plumbing ☐ Basement wo/plumbing

Comments:/Conditions:

Must have 36" Trench Bottom

700


Comments:/Conditions:

Installed @ 30"


Installed on Contour

Maintain all set backs

INITIAL SITE SKETCH

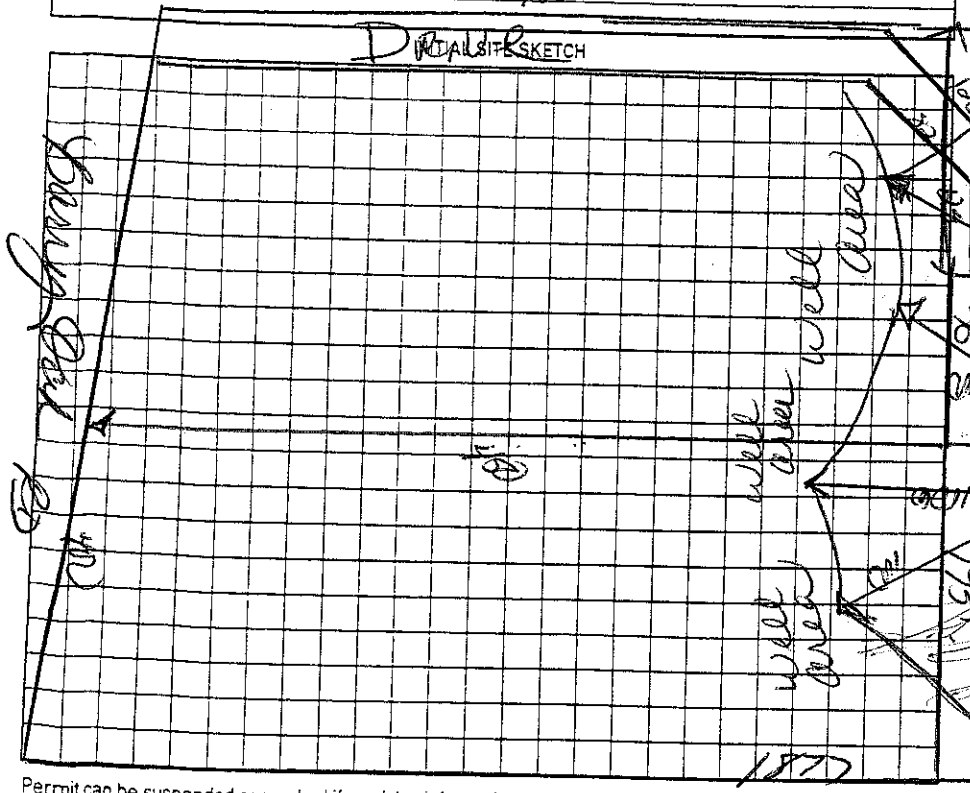

AS BUILT SKETCH

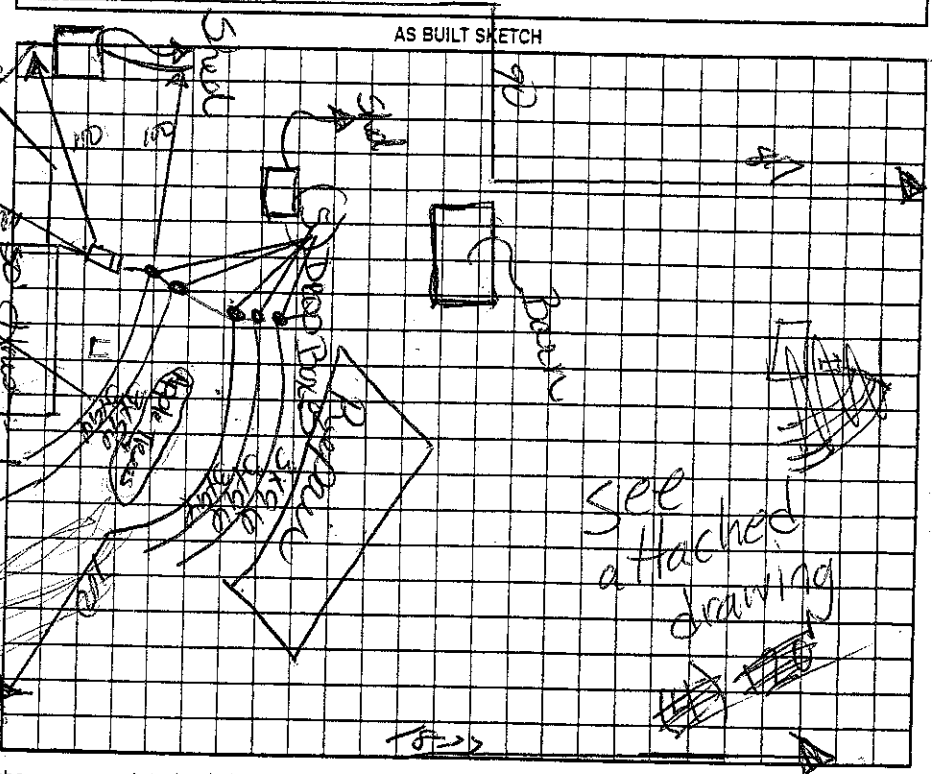

Permit can be suspended or revoked if any false information is supplied toward securing the permit/any unauthorized changes are made to the site/any unauthorized changes are made in the installation of the system. Improvement Permit with plat valid without expiration ☐ Improvement Permit with site plan valid for sixty months ☑

Authorization to Construct is valid for a period equal to that of Improvement Permit – not to exceed sixty months.

Signed: date

Improvement Permit by: date 9-24-08

Authorization to Construct by: date 9-26-08

Installed by: Rowan Septic

Operation Permit by: date 1-9-12

Existing System Inspection by: date

HEALTH DEPT. COPY: WHITE OWNER COPY (FINAL): YELLOW OWNER COPY (INITIAL): PINK