IREDELL COUNTY HEALTH DEPARTMENT

STATESVILLE 704-878-5305 MOORESVILLE 704-664-5281

IMPROVEMENT PERMIT / AUTHORIZATION TO CONSTRUCT / OPERATION PERMIT / EXISTING SYSTEM INSPECTION

PERMIT# 86350 PIN# 4785317174 DATE 11-23-99

OWNER OR CONTRACTOR Danny Brown PHONE: Business Home 871-8203

ADDRESS 166 Roche moore Dr. Statesville

LOCATION 6mi E TR Barry Oak TR Houston 500' Rt.

SUBDIVISION BLOCK / SECTION LOT LOT AREA 1.98 acres SITE CLASS PS DESIGN FLOW 360 L.T.A.R. .3

Septic Tank: 1000 Gallons; STB 786 Date 11 00

Pump Tank: Gallons; PT Date

Pump Make: Model Serial No.

Nitrification Field: No Fields 1 Square Feet 1200 Linear Feet 400

No Lines 3 Trench Width 36" Max Trench Bottom Depth 36" Gravel Depth 12"

~~New System~~ Repair System Type: I II III IV V VI

System Description: Conv. Gravity

Repair System Description:

Maintenance Agreement Required: Yes ~~No~~

~~House/Mod. Home~~ No. Bedrooms 3

Mobile Home No. Bathrooms 2

Business No. Employees

Other


~~Slab~~ ~~Crawl Space~~ Basement w/plumbing Basement wo/plumbing

Water Supply: Individual ~~Public~~ Community


Comments/Conditions:

Comments/Conditions

INITIAL SITE SKETCH

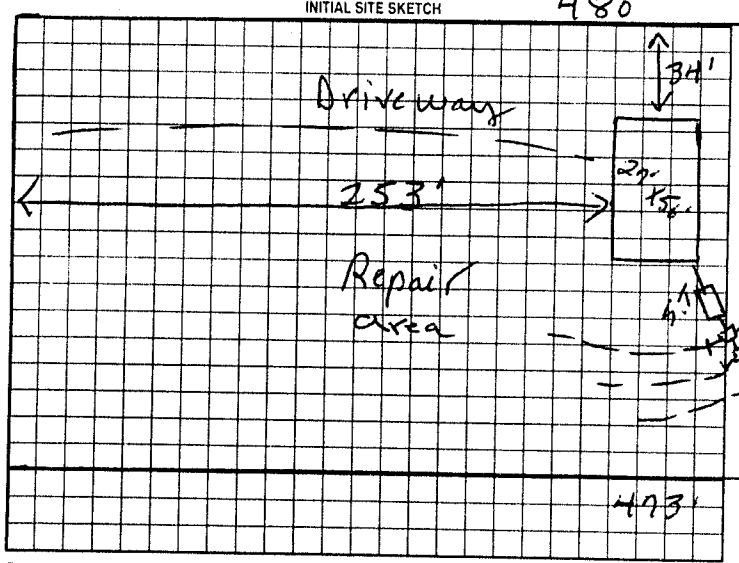

AS BUILT SKETCH

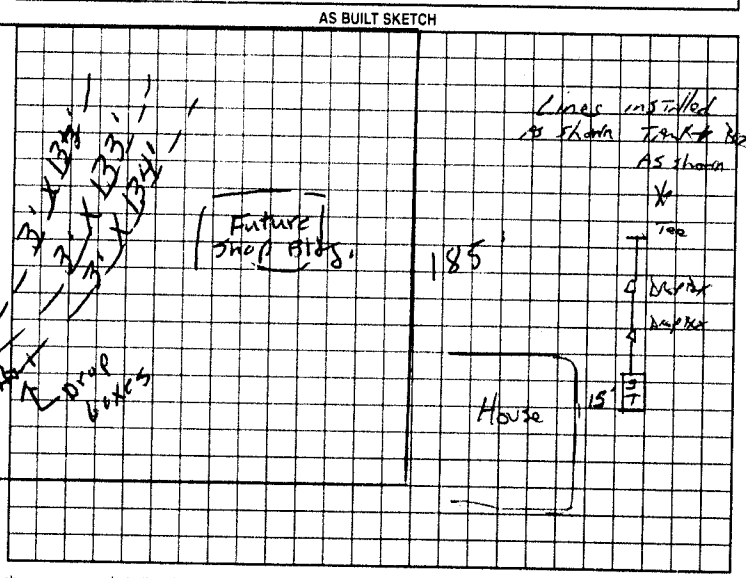

Permit can be suspended or revoked if any false information is supplied toward securing the permit/any unauthorized changes are made to the site/any unauthorized changes are made in the installation of the system. Improvement Permit with plat valid without expiration. Improvement Permit with site plan valid for sixty months. Authorization to Construct is valid for a period equal to that of Improvement Permit – not to exceed sixty months.

Signed: X Danny Brown date Installed by: Larry Repp & Son

Improvement Permit by: P. C. Moore date 11-23-99 Operation Permit by: date March 23 2000

Authorization to Construct by: P. C. Moore date 11-23-99 Existing System Inspection by: date

HEALTH DEPT COPY WHITE OWNER COPY (FINAL) YELLOW OWNER COPY (INITIAL) PINK