IREDELL COUNTY HEALTH DEPARTMENT

STATESVILLE 704-878-5305 MOORESVILLE 704-664-5281

IMPROVEMENT PERMIT / AUTHORIZATION TO CONSTRUCT / OPERATION PERMIT / EXISTING SYSTEM INSPECTION

PERMIT# 148434 PIN# 4785338794 DATE 20 Feb 08

OWNER OR APPLICANT Harold & Neoma Teaster PHONE: Business 704-872-6045 Home

ADDRESS 651 Barnard Rd Cleveland NC 27013

LOCATION 64E (R) Barry Oak (L) 1st drive past Fairy Hill RD

SUBDIVISION BLOCK / SECTION LOT LOT AREA 3.30 SITE CLASS. P5 DESIGN FLOW 360 L.T.A.R.

Septic Tank: 1000 Gallons: STB Date

Pump Tank: Gallons: PT Date

Pump Make: Model Serial No.

Nitrification Field: No Fields Square Feet 1200 Linear Feet 1057

No Lines Trench Width 36 Max Trench Bottom Depth 24" Gravel Depth 12

☐ New System ☐ Repair ☐ Expansion System Type: I (II) III IV V VI

System Description: Existing

Repair System Description:

Maintenance Agreement Required: ☐ Yes ☐ No

☐ House/Mod. Home No. Bedrooms 3

☐ Mobile Home No. Persons 2

☐ Business No. Employees

☐ Other

Water Suppiy: ☑ Individual ☐ Public ☐ Community


☐ Gravity ☐ Pressure ☐ Slab ☑ Crawl Space ☐ Basement w/plumbing ☐ Basement wo/plumbing

Comments:/Conditions:


Comments:/Conditions:

Long Deep SD encountered & Failed at time of inspection

INITIAL SITE SKETCH

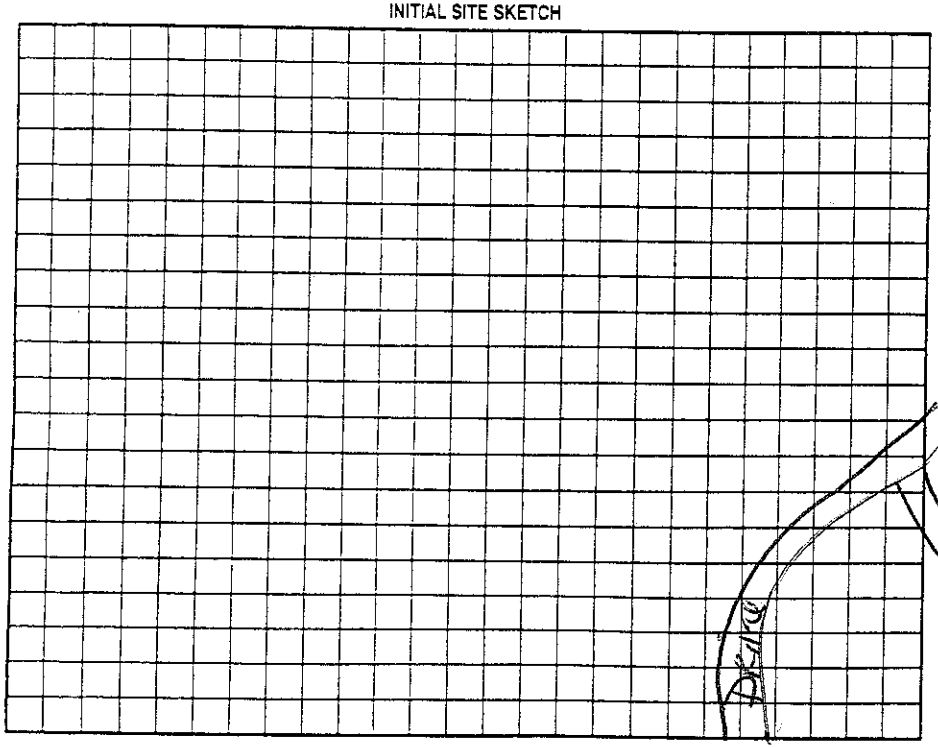

AS BUILT SKETCH

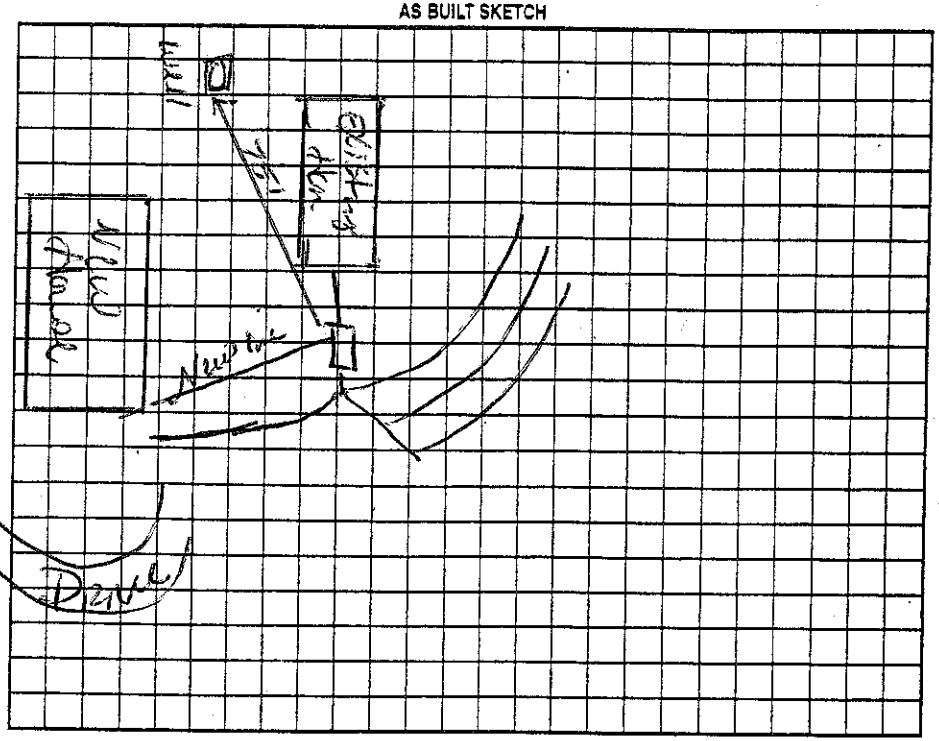

Permit can be suspended or revoked if any false information is supplied toward securing the permit/any unauthorized changes are made to the site/any unauthorized changes are made in the installation of the system. Improvement Permit with plat valid without expiration ☐ Improvement Permit with site plan valid for sixty months ☑ Authorization to Construct is valid for a period equal to that of Improvement Permit – not to exceed sixty months.

Signed: date Installed by:

Improvement Permit by: date Operation Permit by: date

Authorization to Construct by: date Existing System Inspection by: Keith Cook date 20-Feb-08

HEALTH DEPT. COPY: WHITE OWNER COPY (FINAL): YELLOW OWNER COPY (INITIAL): PINK