IREDELL COUNTY HEALTH DEPARTMENT

STATESVILLE 704-878-5305 MOORESVILLE 704-664-5281

IMPROVEMENT PERMIT / AUTHORIZATION TO CONSTRUCT / OPERATION PERMIT / EXISTING SYSTEM INSPECTION

I

PERMIT# 110782 PIN# ~~4785-42-4525~~ 4785-42-4661 DATE 01-29-03

OWNER OR CONTRACTOR LYNN QUERCASIT PHONE: Business 704-880-3232 CELL Home 704-871-9331

ADDRESS 691 BARRY OAK RD CLEVELAND, NC 27013

LOCATION HWY 64 EAST, (E) BARRY OAK RD, (L) AT ~~BOX~~ 691, (RIGHT AFTER BARNHILL RD

SUBDIVISION _____ BLOCK / SECTION _____ LOT _____ LOT AREA 3.9 AC SITE CLASS. PS DESIGN FLOW 360 L.T.A.R. .3

Septic Tank: 1000 Gallons; STB 1012 Date 10-12-02
Pump Tank: 1000 Gallons; PT 17 Date 02-09-02
Pump Make: GOULDS Model WE0311M Serial No. IPWE0311M
Nitrification Field: No Fields 1 Square Feet 1200' Linear Feet 400'
No Lines 4X100' Trench Width 36" Max Trench Bottom Depth 36" Gravel Depth 12"

☒ New System ☐ Repair System Type: I, II, (III) IV, V, VI
System Description: PUMP GRAVEL/CONV
Repair System Description: PUMP 25% REDUCT
Maintenance Agreement Required: ☐ Yes ☒ No


☒ House/Mod Home ☐ Mobile Home ☐ D/W No. Bedrooms 3 No. Bathrooms 2
☐ Business No. Employees _____
☐ Other _____
☐ Slab ☒ Crawl Space ☐ Basement w/plumbing ☐ Basement wo/plumbing

Water Supply: ☐ Individual ☒ Public ☐ Community IREDELL H2O

Comments/Conditions: (1) TALKED TO OWNER & SHE IS BUYING PROPERTY BEHIND THE NEW D/W. I GAVE HER THE OK TO MOVE THE HOUSE BECAUSE THE DRAINFIELD & 294.51'

Comments/Conditions: REPAIR WILL NOT BE AFFECTED. SHE CAN MOVE IT BACKWARD NOT FORWARD JUST MAINTAIN SETBACKS. (2) CALL PRIOR TO INSTALLATION FOR PUMP SIZING. (3) SYSTEM & HOUSE ARE FLAGGED OUT ENTIRELY. TRUTH 30" DEEP

AS BUILT SKETCH "NOT TO SCALE"

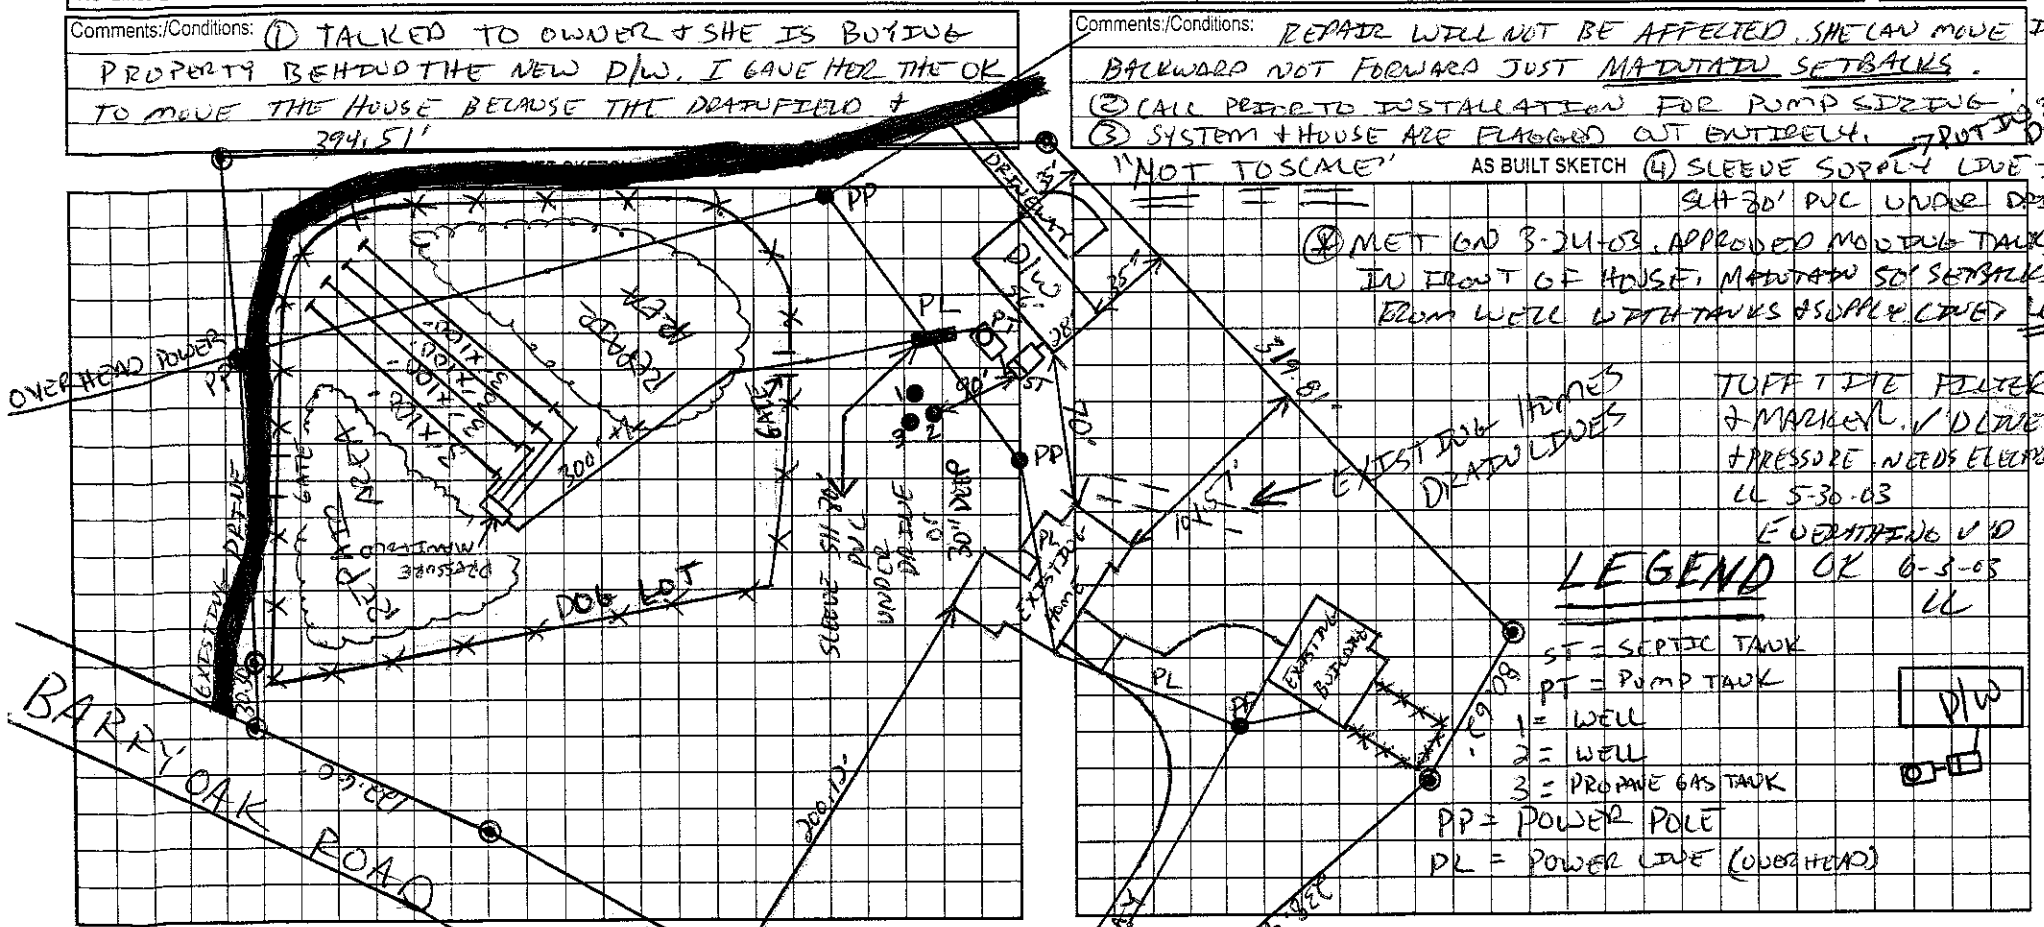

(4) SLEEVE SUPPLY LINE TO SHED 30' PVC UNDER DRIVE.

(5) MET ON 3-24-03. APPROVED MODULE TANKS IN FRONT OF HOUSE, MAINTAIN 50' SETBACKS FROM WELL WITH TANKS & SUPPLY LINES. LL

TUFF TITE FILTER & MARKER. V. DAVIS & PRESSURE NEEDS ELEVATION LL 5-30-03

EVERYTHING WAS OK 6-3-03 LL

Permit can be suspended or revoked if any false information is supplied toward securing the permit/any unauthorized changes are made to the site/any unauthorized changes are made in the installation of the system. Improvement Permit with plat valid without expiration. Improvement Permit with site plan valid for sixty months. Authorization to Construct is valid for a period equal to that of Improvement Permit – not to exceed sixty months.

Signed: Lynn C. Quercasit date _____ Installed by: STEVE JORAN

Improvement Permit by: [signature] date 01-29-03 Operation Permit by: [signature] date 6-3-03

Authorization to Construct by: [signature] date 01-29-03 Existing System Inspection by: _____ date _____

HEALTH DEPT. COPY: WHITE OWNER COPY (FINAL): YELLOW OWNER COPY (INITIAL): PINK