782 Barry Oak Rd

IREDELL COUNTY HEALTH DEPARTMENT

STATESVILLE 704-878-5305 MOORESVILLE 704-664-5281

IMPROVEMENT PERMIT / AUTHORIZATION TO CONSTRUCT / OPERATION PERMIT / EXISTING SYSTEM INSPECTION

PERMIT# ~~[illegible]~~ 20766 2 PIN# 4785624547 4785-62-7962 DATE 5-25-07

OWNER OR APPLICANT Cindy Robinson PHONE: Business 704-876-6948 Home

ADDRESS ~~[illegible]~~ 111 Briarwood Drive Statesville NC

LOCATION Left (TR) Barry Oak Lot on Right After 732 Barry Oak

SUBDIVISION BLOCK/SECTION LOT LOT AREA + 1.00 – SITE CLASS. 15 DESIGN FLOW 360 L.T.A.R. .25

Septic Tank: 1000 Gallons: STB 760 Date 8-2-15
Pump Tank: N/A Gallons: PT N/A Date N/A
Pump Make: N/A Model Pow/Flo Serial No. PL-68
Nitrification Field: No Fields 1 Square Feet 1440 Linear Feet 360
No Lines 3 Trench Width 24" Max Trench Bottom Depth 36" Gravel Depth

☑ New System ☐ Repair ☐ Expansion System Type: I II III IV V VI
System Description: 25% Conv.
Repair System Description: 25% Conv.
Maintenance Agreement Required: ☐ Yes ☑ No

☑ House/Mod. Home No. Bedrooms 3
☐ Mobile Home No. Persons
☐ Business No. Employees
☐ Other


Water Supply: ☐ Individual ☑ Public ☐ Community

☐ Gravity ☐ Pressure ☐ Slab ☑ Crawl Space ☐ Basement w/plumbing ☐ Basement wo/plumbing

Comments:/Conditions:
Located on Contour
Maintain all setbacks

Comments:/Conditions:

INITIAL SITE SKETCH

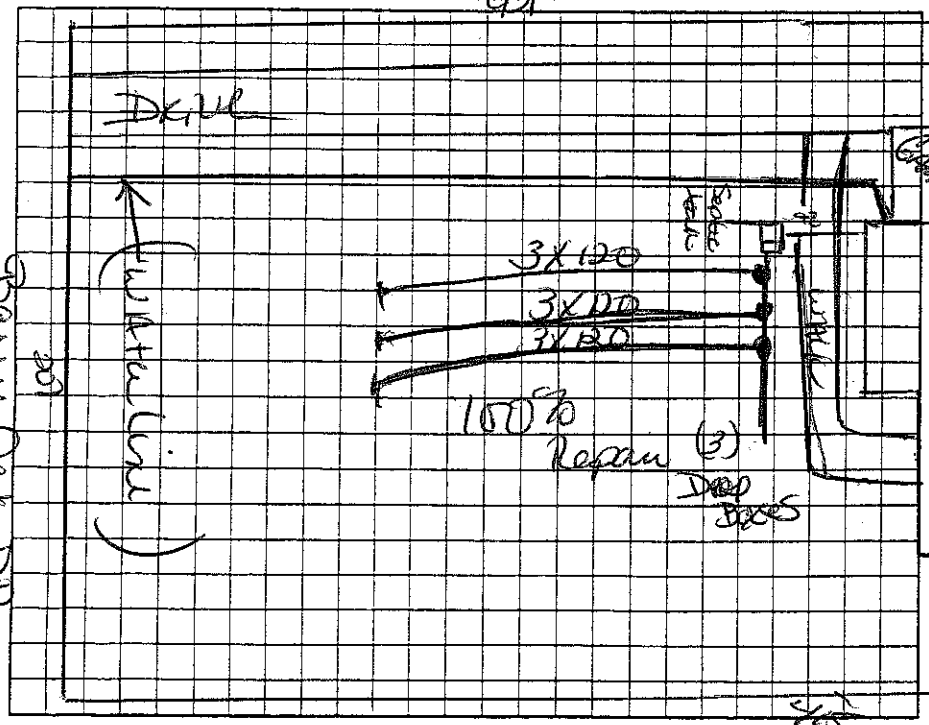

AS BUILT SKETCH

Permit can be suspended or revoked if any false information is supplied toward securing the permit/any unauthorized changes are made to the site/any unauthorized changes are made in the installation of the system. Improvement Permit with plat valid without expiration ☐ Improvement Permit with site plan valid for sixty months ☐ Authorization to Construct is valid for a period equal to that of Improvement Permit – not to exceed sixty months.

Signed: Cindy Robinson date 5-25-07
Improvement Permit by: Jack Cook date 5-25-07
Authorization to Construct by: Jack Cook date 5-25-07

Installed by: Shannon Henderson (Groundbreakers)
Operation Permit by: [signature] date 03/04/15
Existing System Inspection by: date

HEALTH DEPT. COPY: WHITE OWNER COPY (FINAL): YELLOW OWNER COPY (INITIAL): PINK