IREDELL COUNTY HEALTH DEPARTMENT - *ENVIRONMENTAL HEALTH* ☑ STATESVILLE OFFICE 704-878-5305 ☐ MOORESVILLE OFFICE 704-664-5281

IMPROVEMENT PERMIT / AUTHORIZATION TO CONSTRUCT / OPERATION PERMIT / EXISTING SYSTEM INSPECTION

PERMIT # 175253 PIN # 4785637392 DATE 10-12-12

OWNER Shane Owens APPLICANT: Erin Owens PHONE: Home/Cell # 704-682-5733 Business # N/A

SITE ADDRESS 779 Barry Oak Rd. OWNER / APPLICANT ADDRESS 777 Barry Oak Rd.

SITE DIRECTIONS Hwy 64E TR Barry Oak Rd. Property on left two lots past Furr Rd.

SUBDIVISION N/A BLOCK / SECTION N/A LOT # N/A LOT AREA 1.37acres DESIGN FLOW 360gpd L.T.A.R. Existing

Septic Tank EX Gallons: STB Date

Pump Tank Gallons: P T Date

Pump Make Model Serial #

No. Nitrification Fields: 1 No. Lines 2 Linear Feet Existing

Trench Width EX Max. Trench Bottom Depth EX. Gravel Depth EX

☐ New System ☐ Repair ☐ Expansion System Type I (II) III IV V VI

System Description: Conventional

Repair System Description:

Maintenance Agreement Required ☐ YES ☑ NO

☑ GRAVITY ☐ PRESSURE

☑ Residence No. Bedrooms 3

☐ Business No. Persons

☐ Other No. Employees


☐ Slab ☑ Crawl Space

☐ Basement w/plumbing ☐ Basement w/o plumbing


Water Supply: ☑ Private ☐ Public ☐ Community

Comments / Conditions - Remove / disconnect existing mobile home from septic system prior to connect new proposed home. Maintain a minimum of 25' between foundation of home & well. Maintain minimum of 5' btw home and all components of septic tank system

INITIAL SITE SKETCH

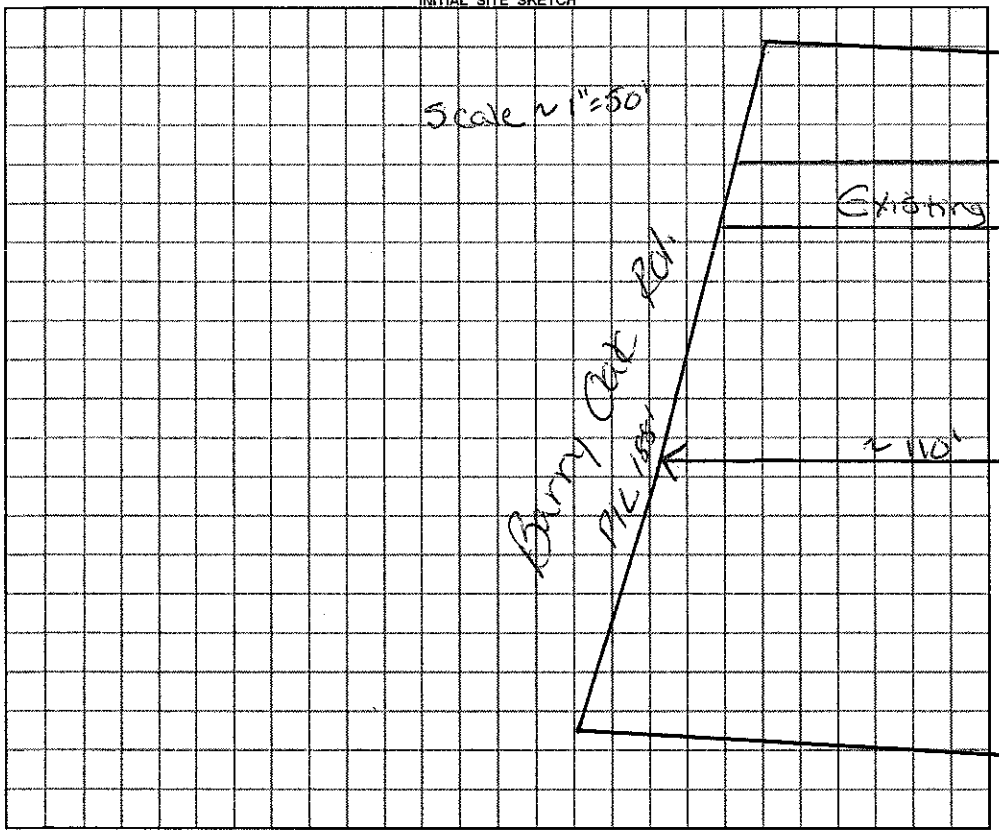

AS BUILT SKETCH

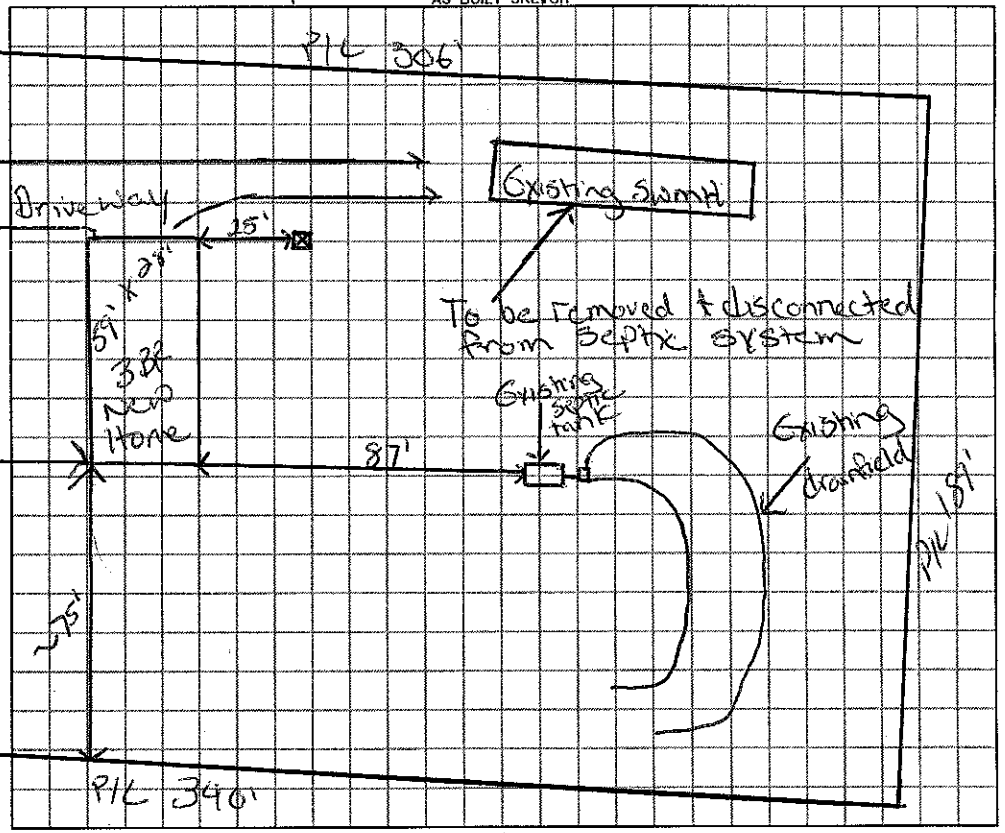

Permit can be suspended or revoked if any false information is supplied toward securing the permit / any unauthorized changes are made to the site / any unauthorized changes are made in the installation of the system.

☐ ***IMPROVEMENT PERMIT*** with plat valid without expiration. ☐ ***IMPROVEMENT PERMIT*** with plat valid without expiration. site plan valid 6 months. ☐ ***AUTHORIZATION TO CONSTRUCT*** valid for period equal to IMPROVEMENT PERMIT--not to exceed 60 mo.

Owner / Applicant Signature: Erin Owens Date 10-16-12 Installed by:

IMPROVEMENT PERMIT by: ***REHS*** Date OPERATION PERMIT by: ***REHS*** Date

AUTHORIZATION TO CONSTRUCT by: ***REHS*** Date Existing System Inspected by: Justin Alexander ***REHS*** Date 10-12-12

YOU SHOULD CONTACT A LOCATOR SERVICE PRIOR TO ANY EXCAVATION

White Copy – Environmental Health YELLOW COPY (Final) Owner / Applicant PINK COPY (Initial) Owner / Applicant