IREDELL COUNTY HEALTH DEPARTMENT - *ENVIRONMENTAL HEALTH*

☐ STATESVILLE OFFICE 704-878-5305 ☐ MOORESVILLE OFFICE 704-664-5281

IMPROVEMENT PERMIT / AUTHORIZATION TO CONSTRUCT + OPERATION PERMIT / EXISTING SYSTEM INSPECTION

PERMIT # 17553 PIN # 4785637392 4785637392 DATE 10-12-12

OWNER [illegible] APPLICANT: [illegible] PHONE: Home/Cell # 704-682-5723 Business # n/a

SITE ADDRESS 729 [illegible] OWNER / APPLICANT ADDRESS 777 [illegible]

SITE DIRECTIONS [illegible]

SUBDIVISION n/a BLOCK / SECTION n/a LOT # n/a LOT AREA 1.32 acres DESIGN FLOW 360 gpd L.T.A.R. 0.45 ac

Septic Tank 1 Gallons: STB [illegible] Date [illegible]

Pump Tank [illegible] Gallons: P T [illegible] Date [illegible]

Pump Make [illegible] Model [illegible] Serial # [illegible]

No. Nitrification Fields: 1 No. Lines 3 Linear Feet 150

Trench Width 24" Max. Trench Bottom Depth 24" Gravel Depth 12"

☐ New System ☐ Repair ☐ Expansion System Type I II III IV V VI

System Description: [illegible]

Repair System Description: [illegible]

Maintenance Agreement Required ☐ YES ☐ NO

☐ GRAVITY ☐ PRESSURE

☒ Residence No. Bedrooms 3

☐ Business No. Persons [illegible]

☐ Other No. Employees [illegible]

☐ Slab ☐ Crawl Space


☐ Basement w/plumbing ☐ Basement w/o plumbing

Water Supply: ☐ Private ☐ Public ☐ Community


Comments / Conditions

[illegible] small SD components of septic [illegible] system

INITIAL SITE SKETCH

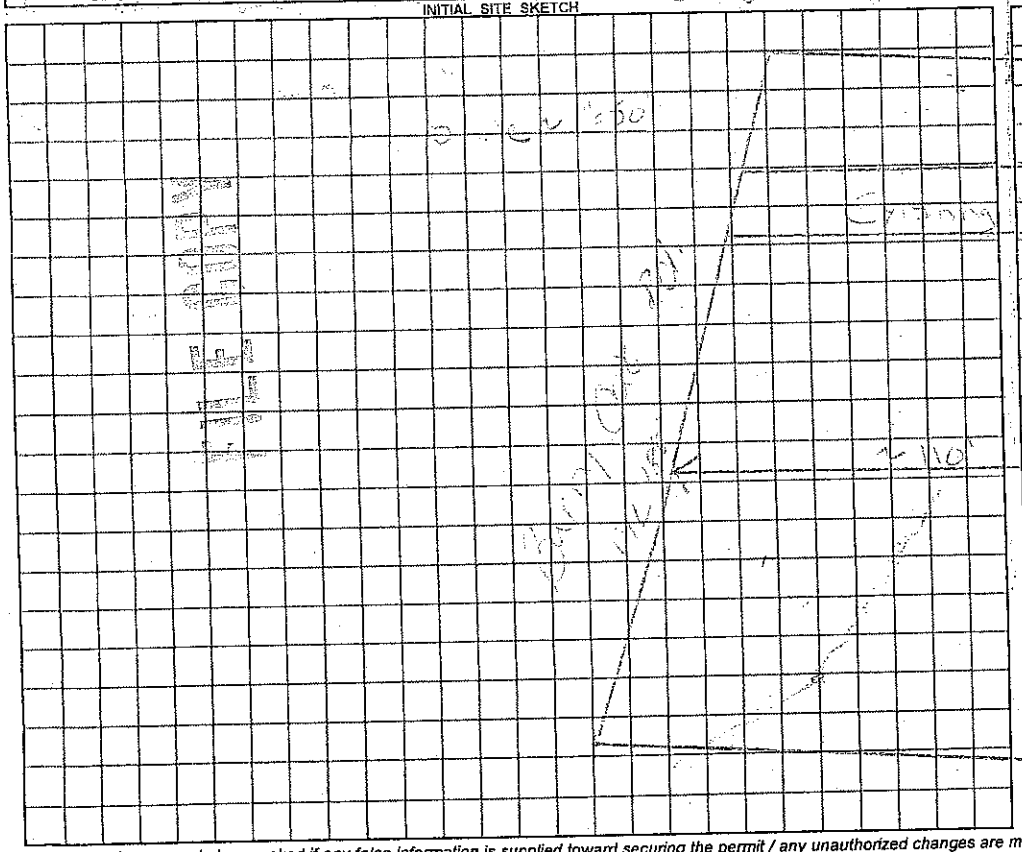

AS BUILT SKETCH

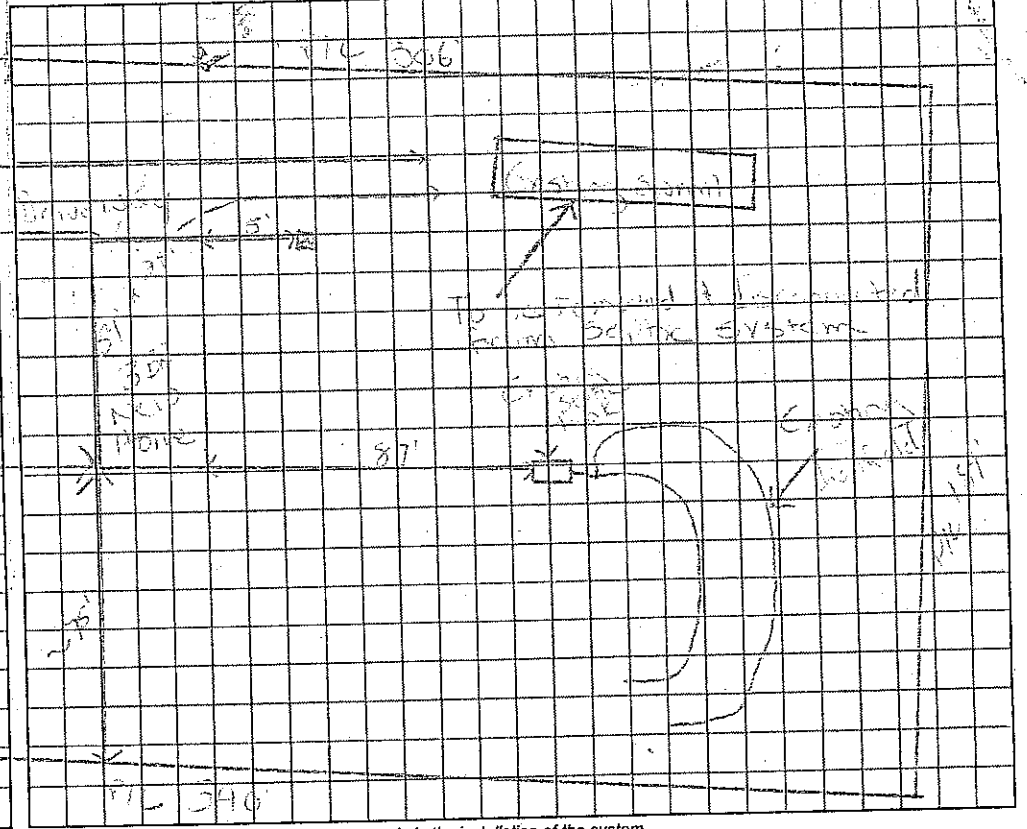

Permit can be suspended or revoked if any false information is supplied toward securing the permit / any unauthorized changes are made to the site / any unauthorized changes are made in the installation of the system.

☐ ***IMPROVEMENT PERMIT*** with plat valid without expiration. ☐ ***IMPROVEMENT PERMIT*** with plat ~~valid without expiration~~ ***site plan valid 60 mo.*** ☐ ***AUTHORIZATION TO CONSTRUCT*** valid for period equal to IMPROVEMENT PERMIT—not to exceed 60 mo.

Owner / Applicant Signature: [illegible] Date [illegible]

IMPROVEMENT PERMIT by: ***REHS*** Date [illegible]

AUTHORIZATION TO CONSTRUCT by: ***REHS*** Date [illegible]

YOU SHOULD CONTACT A LOCATOR SERVICE PRIOR TO ANY EXCAVATION

Installed by: [illegible]

OPERATION PERMIT by: ***REHS*** Date [illegible]

Existing System Inspected by: [illegible] ***REHS*** Date 10-12-12

White Copy – Environmental Health YELLOW COPY (Final) Owner / Applicant PINK COPY (Initial) Owner / Applicant