IREDELL COUNTY HEALTH DEPARTMENT

STATESVILLE 704-878-5305 (ad) MOORESVILLE 704-664-5281

IMPROVEMENT PERMIT / AUTHORIZATION TO CONSTRUCT / OPERATION PERMIT / EXISTING SYSTEM INSPECTION

PERMIT # 54754 PIN # 4785-64-6597 3125 DATE 2-25-09

OWNER or APPLICANT Ronald and Michelle Roberts PHONE: Business Home: 704-872-8543

OWNER or APPLICANT ADDRESS 139 Sparrow Lane Statesville

LOCATION / DIRECTIONS 64E (R) Barry Rd (R) Turn R 1/2 mile on left

SUBDIVISION BLOCK / SECTION LOT # 1 LOT AREA 2+AC DESIGN FLOW 360 L.T.A.R. 2

Septic Tank 1000 Gallons: STB 1012 Date 4-25-08 ☑ New System ☐ Repair ☐ Expansion System Type I II III IV V VI

Pump Tank Gallons: PT Date System Description: 2570 Gravity

Pump Make Model Serial # Repair System Description: 2570 Gravity

Nitrification Field No Fields No Lines 64 Linear Feet 450 Maintenance Agreement Required ☐ YES ☑ NO

Trench Width 36" Max. Trench Bottom Depth 36" Gravel Depth N/A ☑ GRAVITY ☐ PRESSURE


☑ Residence No. Bedrooms 3 ☐ Business No. Persons ☐ Other No. Employees ☐ Slab ☐ Crawl Space ☐ Basement w/plumbing ☐ Basement w/o plumbing

Water Supply ☑ Private ☐ Public ☐ Community


Comments / Conditions Ensure 36" Trench Bottom

Comments / Conditions $ @ 1250 each
Install on Contour
Maintain all setbacks
Yellow flag Septic tank area

INITIAL SITE SKETCH

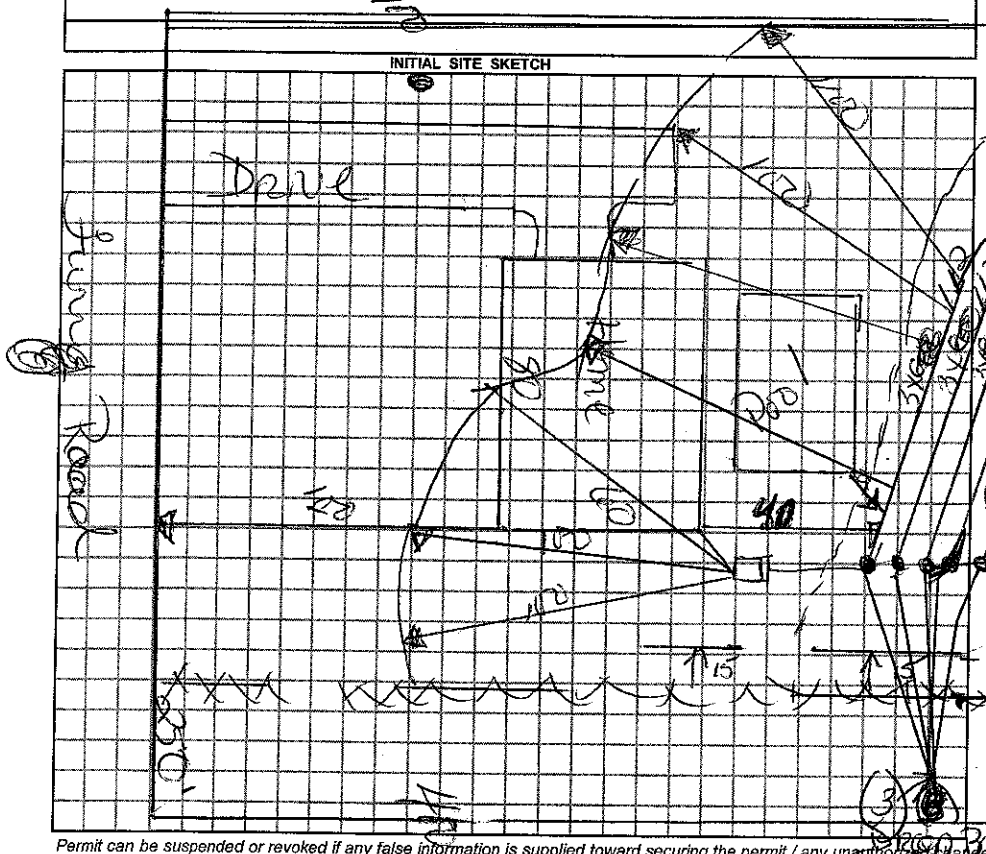

AS BUILT SKETCH

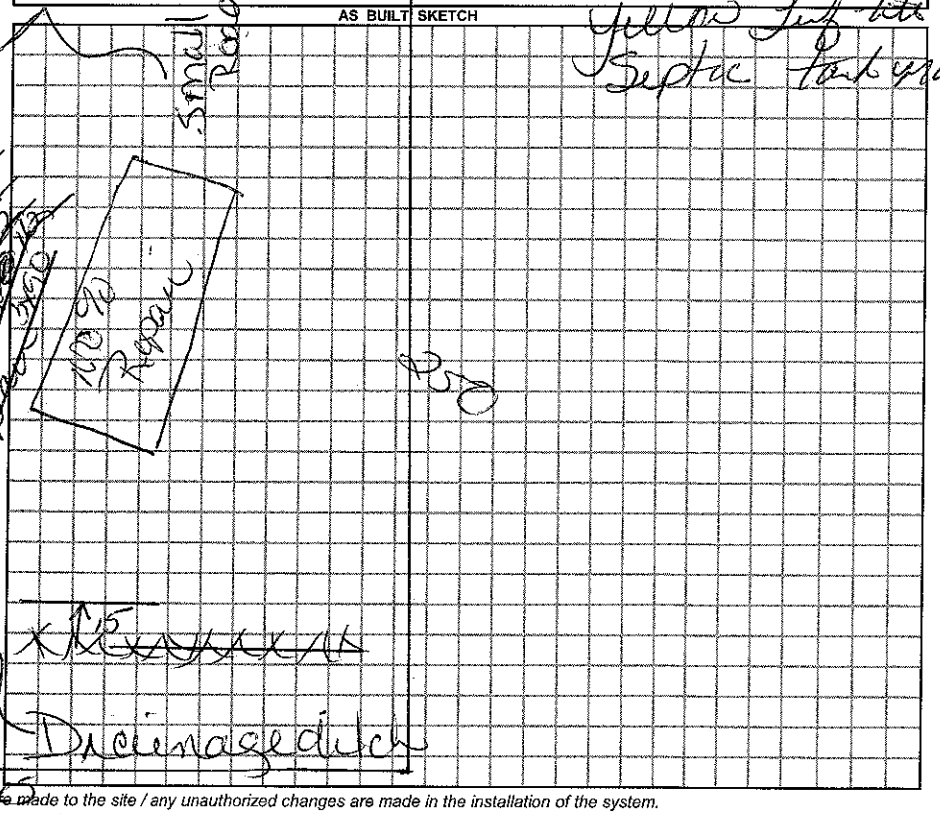

Permit can be suspended or revoked if any false information is supplied toward securing the permit / any unauthorized changes are made to the site / any unauthorized changes are made in the installation of the system.

☐ *IMPROVEMENT PERMIT w / plat valid without expiration.* ☐ *IMPROVEMENT PERMIT w / site plan valid for 60 mos.* ☑ *AUTHORIZATION TO CONSTRUCT valid for period equal to IMPROVEMENT PERMIT-not to exceed 60 mo.*

Owner / Applicant Signature: Date 2/25/09

Improvement Permit by: Date 2-25-09

Authorzation to Construct by: Date 2-25-09

YOU SHOULD CONTACT A LOCATOR SERVICE PRIOR TO ANY EXCAVATION.

Installed by: Gourdy Beaton

Operation Permit by: Date: 4-27-09

Existing System Inspected by: Date:

WHITE COPY Environmental Health YELLOW COPY (Final) Owner / Applicant PINK COPY (Initial) Owner / Applicant