CI

IREDELL COUNTY HEALTH DEPARTMENT

STATESVILLE 704-878-5305 (1) MOORESVILLE 704-664-5281

IMPROVEMENT PERMIT / AUTHORIZATION TO CONSTRUCT / OPERATION PERMIT / EXISTING SYSTEM INSPECTION

PERMIT# 104954 PIN# 4785-20-7691 DATE 03-19-02

OWNER OR CONTRACTOR GARY BUMGARNER PHONE Business MAIY- 704-872-1232 Home 336-492-5943

ADDRESS 173 CAMBRIDGE LANE, MOCKSVILLE NC 27028

LOCATION 64 EAST, R BARRY OAK, R BUMGARNER, AT END (HOUSE ON HILL) TAKE LEFT OFF ROAD

SUBDIVISION _____ BLOCK / SECTION _____ LOT _____ LOT AREA 21.5 AC SITE CLASS PS DESIGN FLOW 360 L.T.A.R. 125

Septic Tank: 1000 Gallons STB 794 Date 10-1-01
Pump Tank: _____ Gallons PT _____ Date _____
Pump Make: _____ Model _____ Serial No _____
Nitrification Field: No Fields 1 Square Feet 1440' Linear Feet 480'
No Lines 4X120' Trench Width 36" Max Trench Bottom Depth 36" Gravel Depth 12"

X New System ☐ Repair System Type: I (II) III IV V VI
System Description: CONV GRAV
Repair System Description: 25% RED/GRAV/PUMP
Maintenance Agreement Required: ☐ Yes X No
☐ Slab X Crawl Space ☐ Basement w/plumbing ☐ Basement wo/plumbing


☐ House/Mod Home No. Bedrooms 3
X Mobile Home (2W) No. Bathrooms 2
☐ Business No. Employees ____
☐ Other ____

Water Supply:
X Individual
☐ Public
☐ Community
WELL/SHARED

Comments/Conditions: (1) HOUSE IS FLAGGED OUT (2) SMOOTH OUT CONTOURS UNIFORM & SMOOTH. (3) GRADE OUT OLD DITCH/TERRACE. (4) MAINTAIN SETBACK, ESPECIALLY OFF SURFACE DIVERSION DITCH & FRENCH DRAIN

Comments/Conditions (5) CALL PRIOR TO INSTALLATION WITH LORAK COOK (704-928-3050) FOR CONSULTATIVE VISIT, (6) INSTALL FRENCH DRAIN 12" DEEPER THAN TRENCH BOTTOM DEPTH (7) PUT SURFACE DIVERSION ABOVE FRENCH DRAIN.

INITIAL SITE SKETCH "NOT TO SCALE"

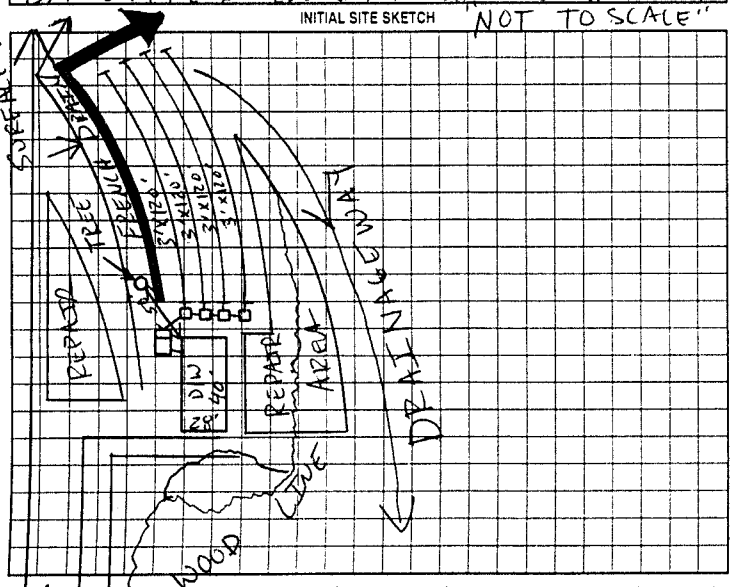

AS BUILT SKETCH

SEPTIC TANK WITH MARKER INSTALLED USING "ZABEL" FILTER

Permit can be suspended or revoked if any false information is supplied toward securing the permit/any unauthorized changes are made to the site/any unauthorized changes are made in the installation of the system. Improvement Permit with plat valid without expiration. Improvement Permit with site plan valid for sixty months. Authorization to Construct is valid for a period equal to that of Improvement Permit - not to exceed sixty months.

Signed: Gary D. Bumgarner date 03-19-02 Installed by: MITCHELL GRADING

Improvement Permit by: Tom Cook RS date 03-19-02 Operation Permit by: STEVE HEDRICK date 6-21-02

Authorization to Construct by: Tom Cook RS date 03-19-02 Existing System Inspection by: _____ date _____

HEALTH DEPT COPY WHITE OWNER COPY (FINAL) YELLOW OWNER COPY (INITIAL) PINK