GRANT DICKERSON TO OLD

IREDELL COUNTY HEALTH DEPARTMENT

STATESVILLE 704-878-5305 MOORESVILLE 704-664-5281

IMPROVEMENT PERMIT / AUTHORIZATION TO CONSTRUCT / OPERATION PERMIT / EXISTING SYSTEM INSPECTION

PERMIT# 92900 PIN# 4785 87 3492 DATE 11-12-00

OWNER OR CONTRACTOR Hubert Dickerson III PHONE, Business 704-995-9905 Home 878 5048

ADDRESS 174 Keaton Rd Cleveland N.C.

LOCATION 64 E TR Barry oak TU Keaton 3/4 mi Rt. Curb in Woods 400' R

SUBDIVISION BLOCK / SECTION LOT LOT AREA 4 acres SITE CLASS PS DESIGN FLOW 360 L.T.A.R. .125

Septic Tank: 1000 Gallons. STB 1012 Date SIT ~~DAYS~~

Pump Tank: Gallons. PT Date 28

Pump Make: Model Serial No

Nitrification Field: No Fields 1 Square Feet 1500 Linear Feet 500

No Lines 4 Trench Width 36" Max Trench Bottom Depth 18 to 20" Gravel Depth 12"

☐ New System ☐ Repair System Type: I (II) III IV V VI

System Description: very Shallow conv. lines

Repair System Description: 1 Y 25% R ☺

Maintenance Agreement Required: ☐ Yes ☑ No

☑ House/Mod. Home No. Bedrooms 3

☐ Mobile Home No. Bathrooms 2

☐ Business No. Employees

☐ Other


☐ Slab ☐ Crawl Space ☐ Basement w/plumbing ☑ Basement wo/plumbing

Water Supply: ☑ Individual ☐ Public ☐ Community


Comments/Conditions: very Shallow Soil Place Drain lines at 18 to 20" + Bring In 6" of cap with Suitable Soils

Comments/Conditions: HAD PITS DUG ON 05-20-02 & LOCATED TRENCH BOTTOM TO 24" DEEP. BRADY, PATRICK, & CLARKE. WITH EVERYTHING ☑'D BUT TANK & SUPPLY LINE (TC) 6-3-02

INITIAL SITE SKETCH

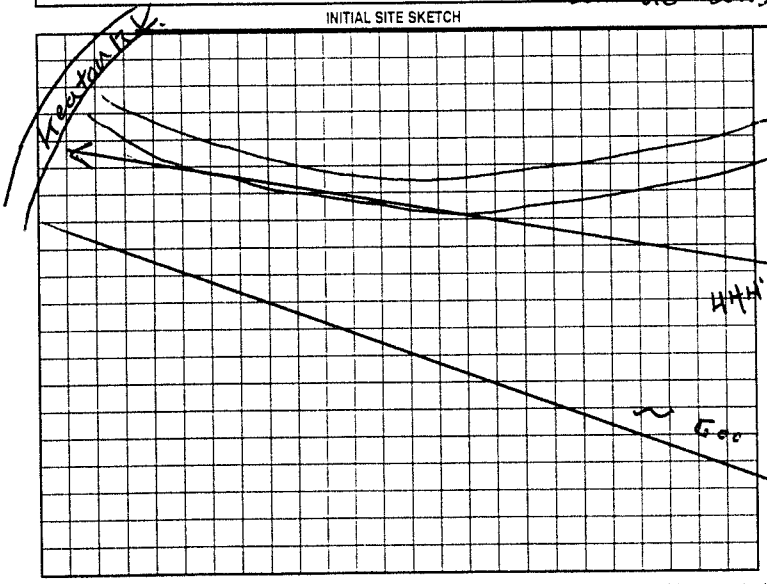

AS BUILT SKETCH POLYLOK FITTER & RISERS

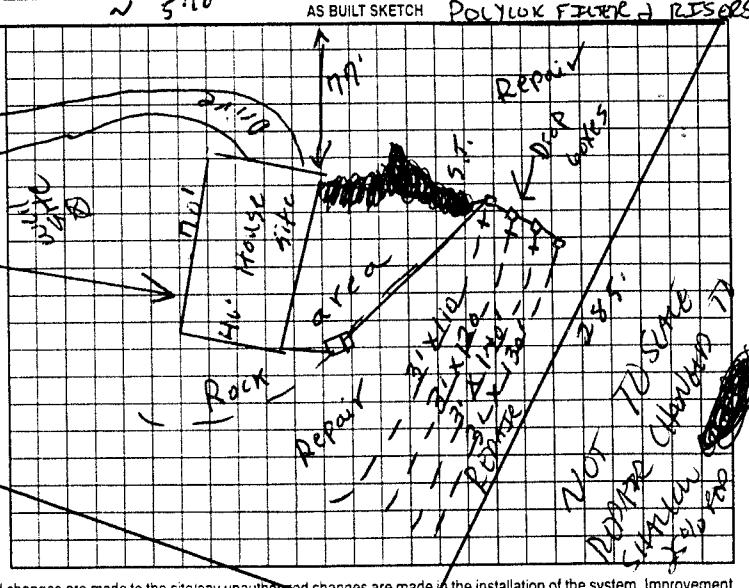

Permit can be suspended or revoked if any false information is supplied toward securing the permit/any unauthorized changes are made to the site/any unauthorized changes are made in the installation of the system. Improvement Permit with plat valid without expiration. Improvement Permit with site plan valid for sixty months. Authorization to Construct is valid for a period equal to that of Improvement Permit – not to exceed sixty months.

Signed: J. H. Dukum III date 11-12-00 Installed by: GRANT DICKERSON

Improvement Permit by: J. C. Moore date 11-12-00 Operation Permit by: [signature] date 06-05-02

Authorization to Construct by: J. C. Moore date 11-12-00 Existing System Inspection by: date

HEALTH DEPT. COPY WHITE OWNER COPY (FINAL) YELLOW OWNER COPY (INITIAL) PINK