19177 on Computer Nixon Computer

IREDELL COUNTY HEALTH DEPARTMENT

STATESVILLE 704-878-5305 MOORESVILLE 704-664-5281

IMPROVEMENT PERMIT / CERTIFICATE OF COMPLETION / OPERATION PERMIT / EXISTING SYSTEM INSPECTION

PROPERTY DESCRIPTION NO. ~~19177~~ 19144 DATE 7-5-94 TAX MAP NO. 11B-A-12 Watershed: [ ] Yes [X] No

OWNER OR CONTRACTOR R.W. Swicegood PHONE: Business ____ Home 872-4057

ADDRESS Rt-2 Cleveland, N.C.

LOCATION 64± TR Barry Oak Rd. Th at Rowan Co. line on Ostrich Lane 1st at 90° curve

SUBDIVISION Saw Mill Mtn. BLOCK / SECTION ____ LOT 13 LOT AREA 1/2 acre SITE CLASS PS DESIGN FLOW 360 L.T.A.R. .35

Septic Tank 1000 Gallons STB N.C.C. Date 12-20-95
Pump Tank ____ Gallons PT ____ Date ____
Pump Make ____ Model ____ Serial No. ____
Notification Hist. No Prev. 1 Square Feet 1035 Floor Elev. 345
No. Lines 4 Trench Width 36" Max. Trench Bottom Depth 36" Gravel Depth 12"

[X] New System [ ] Repair System Type: [I], II, III, IV, V, VI
System Description Conv. Gravity
Repair System Description ____
Maintenance Agreement Required [ ] Yes [X] No
[ ] Slab [ ] Crawl Space [ ] Basement w/plumbing [ ] Basement w/o plumbing


[ ] House/Mod. Home No. Bedrooms 3
[X] Mobile Home No. Bathrooms 1
[ ] Business No. Employees ____
[ ] Other ____

Water Supply: [X] Individual [ ] Community [ ] Public


Comments ____

Comments: mobile Home was not on site at time of this Inspection Keep Drop Distance from S.T.

INITIAL SITE SKETCH

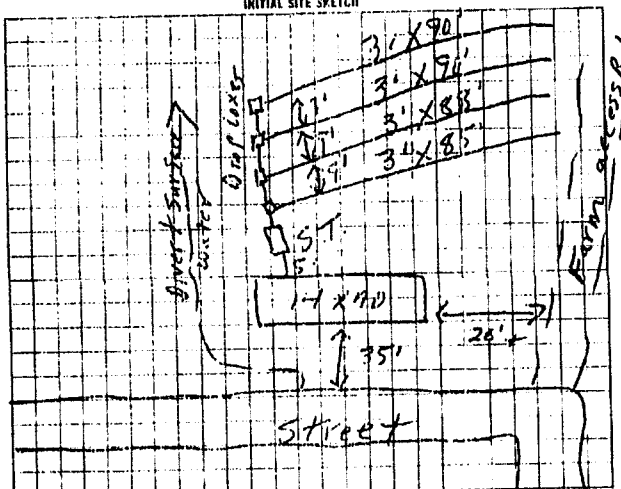

AS BUILT SKETCH

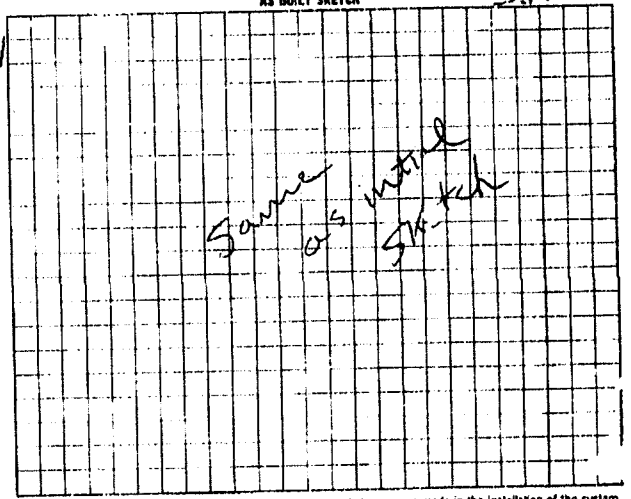

I understand that this permit can be suspended or revoked if any false information is supplied toward securing the permit, any unauthorized changes are made to the site, any unauthorized changes are made in the installation of the system. Improvement Permit is valid for 60 months from date of issuance

Signed X R.W. Swicegood

Improvement Permit by P.C. Moore date 7-5-94

Existing System Inspection by ____ date ____

Installed by: Larry Powell

Certificate of Completion by: P.C. Moore date 2-7-95

Operation Permit by ____ date ____

PINK-HEALTH DEPT COPY WHITE BUILDER COPY (FINAL) GREEN OWNER COPY (FINAL) YELLOW INSPECTION COPY (INITIAL) PINK OWNER COPY (INITIAL) GOLD

JAN. 1, 1989 6:27