IREDELL COUNTY HEALTH DEPARTMENT

STATESVILLE 704-878-5305 MOORESVILLE 704-664-5281 CI

IMPROVEMENT PERMIT / AUTHORIZATION TO CONSTRUCT / OPERATION PERMIT / EXISTING SYSTEM INSPECTION

PERMIT# 102811 PIN# 4785-84-5449 DATE 10-22-01

OWNER OR CONTRACTOR JOHN GODBEY PHONE: Business Home 704-924-9256

ADDRESS 122 OSTRICH LANE CLEVELAND NC 27013

LOCATION I-77 EXIT 45 (R) BARRIER (L) OSTRICH IMMEDIATELY ON LEFT

SUBDIVISION BLOCK / SECTION LOT LOT AREA SITE CLASS DESIGN FLOW 240 L.T.A.R.

EXISTING

Septic Tank: — Gallons: STB Date

Pump Tank: Gallons: PT Date

Pump Make: Model Serial No.

Nitrification Field: No Fields Square Feet Linear Feet 2401

No Lines 3 x 80' Trench Width Max Trench Bottom Depth

☐ New System ☐ Repair System Type: I (II) III IV V VI

System Description: EXISTING

Repair System Description: 2 PANEL

Maintenance Agreement Required: ☐ Yes X No

☐ House/Mod. Home No. Bedrooms 2

X Mobile Home No. Bathrooms 2

☐ Business No. Employees

☐ Other

☐ Slab ☐ Crawl Space ☐ Basement w/plumbing ☐ Basement wo/plumbing


Water Supply:
X Individual
☐ Public
☐ Community
SHARED WELL

Comments/Conditions: (1) LINES TO DEEP TO PROBE (2) VISUALLY SAW 3 LINES - 80' LONG (3) MAINTAIN SETBACKS

Comments/Conditions:

INITIAL SITE SKETCH

AS BUILT SKETCH

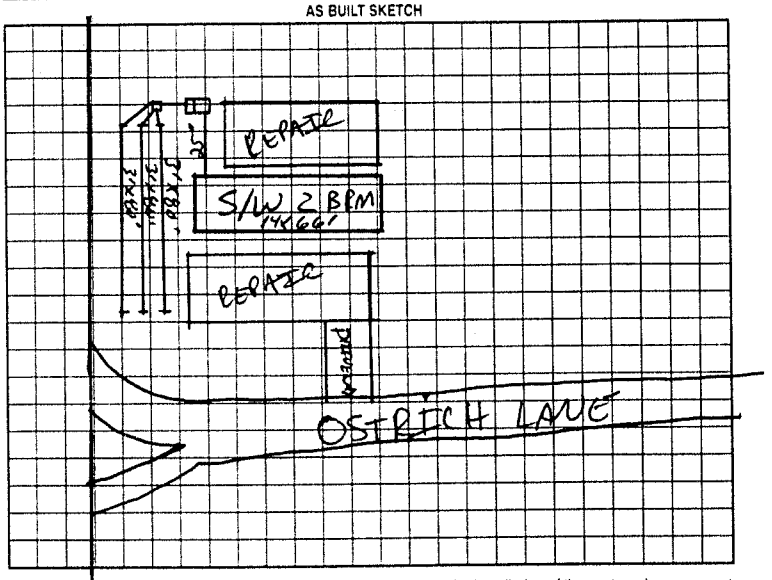

Permit can be suspended or revoked if any false information is supplied toward securing the permit/any unauthorized changes are made to the site/any unauthorized changes are made in the installation of the system. Improvement Permit with plat valid without expiration. Improvement Permit with site plan valid for sixty months. Authorization to Construct is valid for a period equal to that of Improvement Permit – not to exceed sixty months.

Signed: Scott Smith date 10-22-01

Installed by:

Improvement Permit by: date

Operation Permit by: date

Authorization to Construct by: date

Existing System Inspection by: date 10-22-01

HEALTH DEPT. COPY WHITE OWNER COPY (FINAL) YELLOW OWNER COPY (INITIAL) PINK