IREDELL COUNTY HEALTH DEPARTMENT

STATESVILLE 704-878-5305 MOORESVILLE 704-664-5281

IMPROVEMENT PERMIT / AUTHORIZATION TO CONSTRUCT / OPERATION PERMIT / EXISTING SYSTEM INSPECTION

PERMIT# 150866 PIN# 4787-~~79-5885~~ 5950379 DATE 5-2-08

OWNER OR APPLICANT Brenda Dixon PHONE: Business Home 704-873-3549

ADDRESS 894 Barnes Oak Road Cleveland NC 27013

LOCATION 64E to Barnes Oak to Keaton

SUBDIVISION _____ BLOCK/SECTION _____ LOT _____ LOT AREA _____ SITE CLASS. B DESIGN FLOW 360 L.T.A.R. _____

Septic Tank: 1000 Gallons: STB _____ Date _____

Pump Tank: _____ Gallons: PT _____ Date _____

Pump Make: _____ Model _____ Serial No. _____

Nitrification Field: No Fields ___ Square Feet 750 Linear Feet 250

No Lines _____ Trench Width _____ Max Trench Bottom Depth _____ Gravel Depth _____ ☐ Gravity ☐ Pressure

☐ ~~New System~~ ☐ Repair ☐ Expansion System Type: I II III IV V VI

System Description: Gravel - Gravity

Repair System Description: 25% Gravity

Maintenance Agreement Required: ☐ Yes ☐ No

☐ House/Mod. Home No. Bedrooms 2

☑ Mobile Home No. Persons ___

☐ Business No. Employees ___

☐ Other _____

☐ Slab ☐ Crawl Space ☐ Basement w/plumbing ☐ Basement wo/plumbing


Water Supply: ☐ Individual ☐ Public ☑ Community well

Comments:/Conditions:


System is a 3 Bedroom
Has 2 Bedroom Trailer on it

Comments:/Conditions:

INITIAL SITE SKETCH

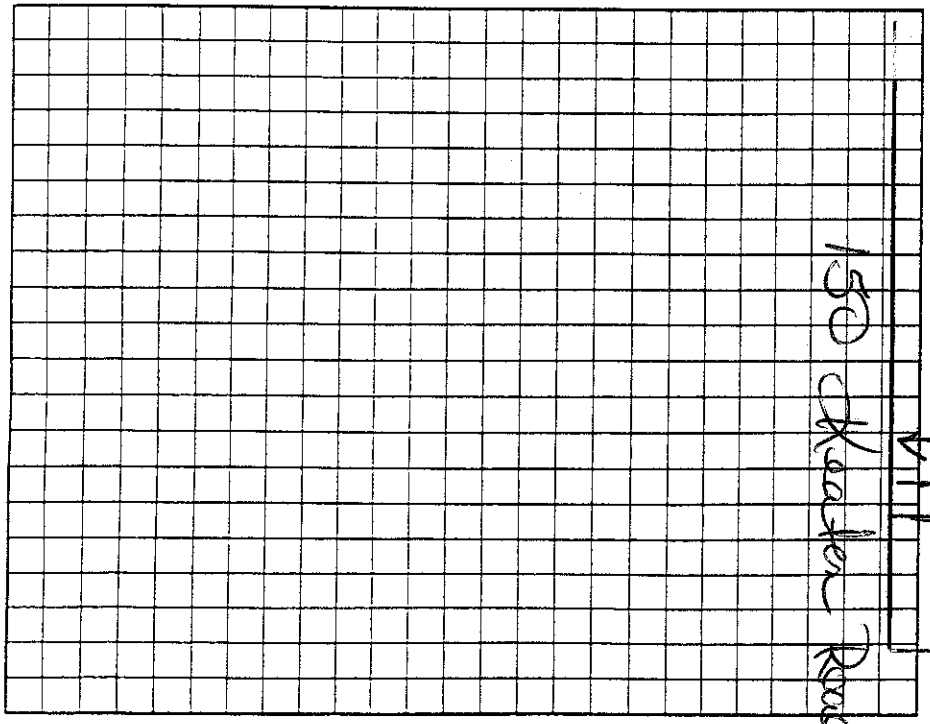

AS BUILT SKETCH

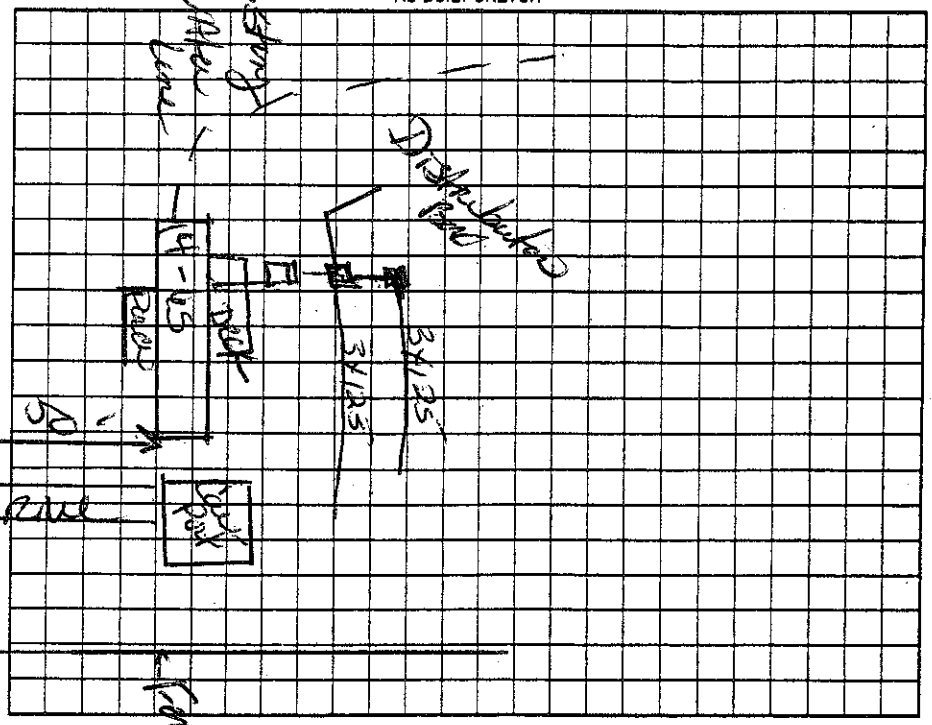

Permit can be suspended or revoked if any false information is supplied toward securing the permit/any unauthorized changes are made to the site/any unauthorized changes are made in the installation of the system. Improvement Permit with plat valid without expiration ☐ Improvement Permit with site plan valid for sixty months ☐ Authorization to Construct is valid for a period equal to that of Improvement Permit – not to exceed sixty months.

Signed: _____ date _____ Installed by: _____

Improvement Permit by: _____ date _____ Operation Permit by: _____ date _____

Authorization to Construct by: _____ date _____ Existing System Inspection by: Kenneth Cook date 5-2-08

HEALTH DEPT. COPY: WHITE OWNER COPY (FINAL): YELLOW OWNER COPY (INITIAL): PINK