Pd. $175.00 10/26/00 dl

IREDELL COUNTY HEALTH DEPARTMENT

STATESVILLE 704-878-5305 MOORESVILLE 704-664-5281

IMPROVEMENT PERMIT / AUTHORIZATION TO CONSTRUCT / OPERATION PERMIT / EXISTING SYSTEM INSPECTION

PERMIT# 92241 PIN# DATE 11-9-00

OWNER OR CONTRACTOR Mark Coleman PHONE: Business 906 1842 Home

ADDRESS 226 Fifth Creek Rd Statesville N.C.

LOCATION US 64 E TL Fifth Creek RD 0.4 MILE on Right

SUBDIVISION Blueberry Hills BLOCK / SECTION LOT 27 LOT AREA 2.5 acre SITE CLASS PS DESIGN FLOW 100 L.T.A.R. .33

Septic Tank: 1000 Gallons: STB 1012 Date 9-10-00
Pump Tank: Gallons: PT Date
Pump Make: Model Serial No.
Nitrification Field: No Fields Square Feet 300 Linear Feet 100
No Lines 2 Trench Width 36" Max Trench Bottom Depth 24" Gravel Depth 12"

☑ New System ☐ Repair System Type: I II III IV V VI
System Description: Conv. Gravity
Repair System Description:
Maintenance Agreement Required: ☐ Yes ☑ No

☐ House/Mod. Home No. Bedrooms
☐ Mobile Home No. Bathrooms 1
☐ Business No. Employees
☐ Other Detached Garage with Bath


☑ Slab ☐ Crawl Space ☐ Basement w/plumbing ☐ Basement wo/plumbing

Water Supply: ☐ Individual ☑ Public ☐ Community


Comments/Conditions: 330'

Comments/Conditions: SEPTIC TANK W/ RISERS INSTALLED USING "POLYLOK" FILTER

INITIAL SITE SKETCH

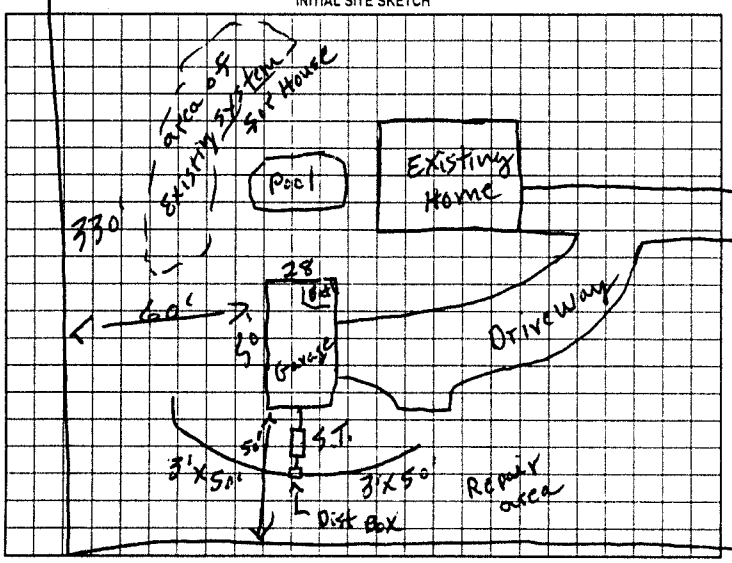

AS BUILT SKETCH

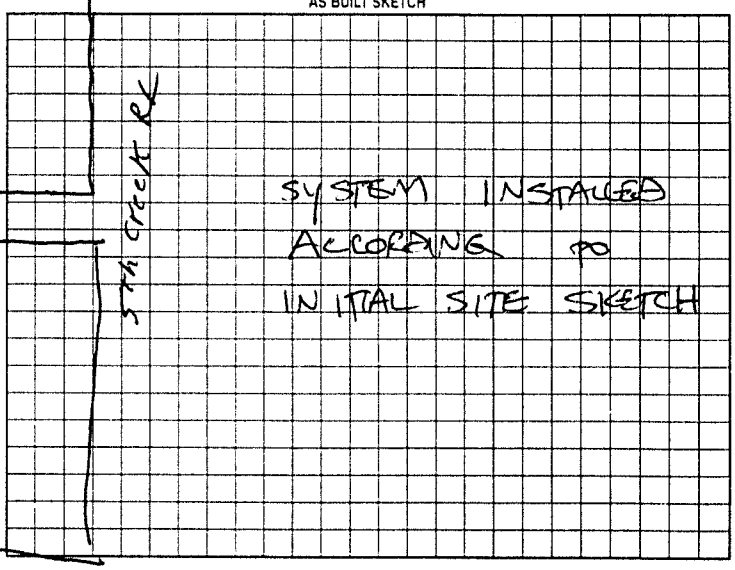

Permit can be suspended or revoked if any false information is supplied toward securing the permit/any unauthorized changes are made to the site/any unauthorized changes are made in the installation of the system. Improvement Permit with plat valid without expiration. Improvement Permit with site plan valid for sixty months. Authorization to Construct is valid for a period equal to that of Improvement Permit – not to exceed sixty months.

Signed: [signature] date 11-9-00 Installed by: DAVID YOUNTS

Improvement Permit by: F.C. Moore date 11-9-00 Operation Permit by: STEVE HEDRICK date 11-15-00

Authorization to Construct by: F.C. Moore date 11-9-00 Existing System Inspection by: date

HEALTH DEPT COPY WHITE OWNER COPY (FINAL) YELLOW OWNER COPY (INITIAL) PINK