IREDELL COUNTY HEALTH DEPARTMENT

STATESVILLE 704-878-5305 MOORESVILLE 704-664-5281

55516

IMPROVEMENT PERMIT / CERTIFICATE OF COMPLETION / OPERATION PERMIT / EXISTING SYSTEM INSPECTION

PROPERTY DESCRIPTION NO. 20776 DATE 4-11-95 TAX MAP NO. 116-1-A-28 Watershed: ☐ Yes ☑ No

OWNER OR CONTRACTOR Mark Phillips PHONE: Business Home 528-9426

ADDRESS 136 Knotty Pine Lane Mooresville

LOCATION 67E TL Fifth Creek Rd past Garris Dr. 2nd lot RT

SUBDIVISION Blueberry Hill BLOCK / SECTION LOT 28 LOT AREA 2.31 acres SITE CLASS. P5 DESIGN FLOW 480 L.T.A.R. .3

Septic Tank: 1000 Gallons; STB Date

Pump Tank: Gallons; PT Date

Pump Make: Model: Serial No.

Nitrification Field: No Fields 1 Square Feet 1600 Linear Feet 533

No Lines 5 Trench Width 36" Max Trench Bottom Depth 24" Gravel Depth 12"

☑ New System ☐ Repair System Type: I, II, III, IV, V, VI

System Description: Conv. Gravity

Repair System Description: Gravity Pipe

Maintenance Agreement Required: ☐ Yes ☑ No

☑ House/Mod. Home ☐ Mobile Home ☐ Business ☐ Other

No. Bedrooms 4 No. Bathrooms 3 No. Employees


☐ Slab ☐ Crawl Space ☐ Basement w/plumbing ☑ Basement wo/plumbing

Water Supply: ☐ Individual ☐ Community ☑ Public

Comments: maximum

Comments: 1500 Gal S.T. Installed

INITIAL SITE SKETCH

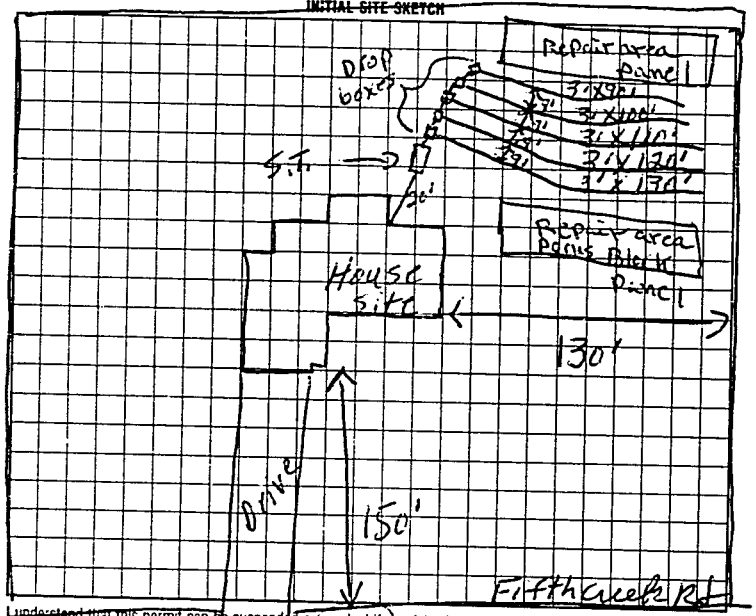

AS BUILT SKETCH

STB 7411 Date 10-20-95

Same as initial sketch

I understand that this permit can be suspended or revoked if any false information is supplied toward securing the permit/any unauthorized changes are made to the site/any unauthorized changes are made in the installation of the system. Improvement Permit is valid for 60 months from date of issuance.

Signed: [signature]

Improvement Permit by: L. C. Moore date 4-11-95

Existing System Inspection by: date

Installed by: James Hustler

Certificate of Completion by: date

Operation Permit by: L. C. Moore date 12-22-95

HEALTH DEPT. COPY: WHITE INSPECTION COPY (FINAL): GREEN OWNER COPY (FINAL): YELLOW INSPECTION COPY (INITIAL): PINK OWNER COPY (INITIAL): GOLD