See attached Permit #162002 for detached garage addition 6/2010.

IREDELL COUNTY HEALTH DEPARTMENT

STATESVILLE 704-878-5305 (X) MOORESVILLE 704-664-5281

IMPROVEMENT PERMIT / AUTHORIZATION TO CONSTRUCT / OPERATION PERMIT / EXISTING SYSTEM INSPECTION

PERMIT# 12100 PIN# 4786-10-7843 6883 DATE 11-19-04

OWNER OR CONTRACTOR MICHAEL MOOREFIELD PHONE: Business 336-399-5943 Home

ADDRESS 345 OLD MOCKSVILLE ROAD, STATESVILLE, NC 28625

LOCATION US 64 EAST, TR LONG POND DRIVE ~900' BACK ON LEFT

SUBDIVISION ~~JOHN MOOREFIELD~~ BLOCK / SECTION TRACT 1 LOT AREA 5.75 ACRES SITE CLASS PS DESIGN FLOW 480 L.T.A.R. 0.30 GPD/FT²

Septic Tank: 1000 Gallons; STB 1012 Date 3-16-06
Pump Tank: ____ Gallons; PT ____ Date ____
Pump Make: ____ Model ____ Serial No. ____
Nitrification Field: No Fields 1 Square Feet 1600 Linear Feet 533
No Lines SIX Trench Width 36" Max Trench Bottom Depth 36" Gravel Depth 12"

☑ New System ☐ Repair System Type: I (II) III IV V VI
System Description: CONVENTIONAL GRAVITY
Repair System Description: CONVENTIONAL GRAVITY
Maintenance Agreement Required: ☐ Yes ☑ No


☑ House/Mod. Home No. Bedrooms 4
☐ Mobile Home No. Bathrooms 3½
☐ Business No. Employees ____
☐ Other ____
☐ Slab ☐ Crawl Space ☑ Basement w/plumbing ☐ Basement wo/plumbing

Water Supply: ☐ Individual ☑ Public ☐ Community

Comments/Conditions: P.L. 209.05' P.L. 120.39' 370.16'

INSTALL DRAIN LINES ON CONTOUR AS FLAGGED ON SITE

INITIAL SITE SKETCH

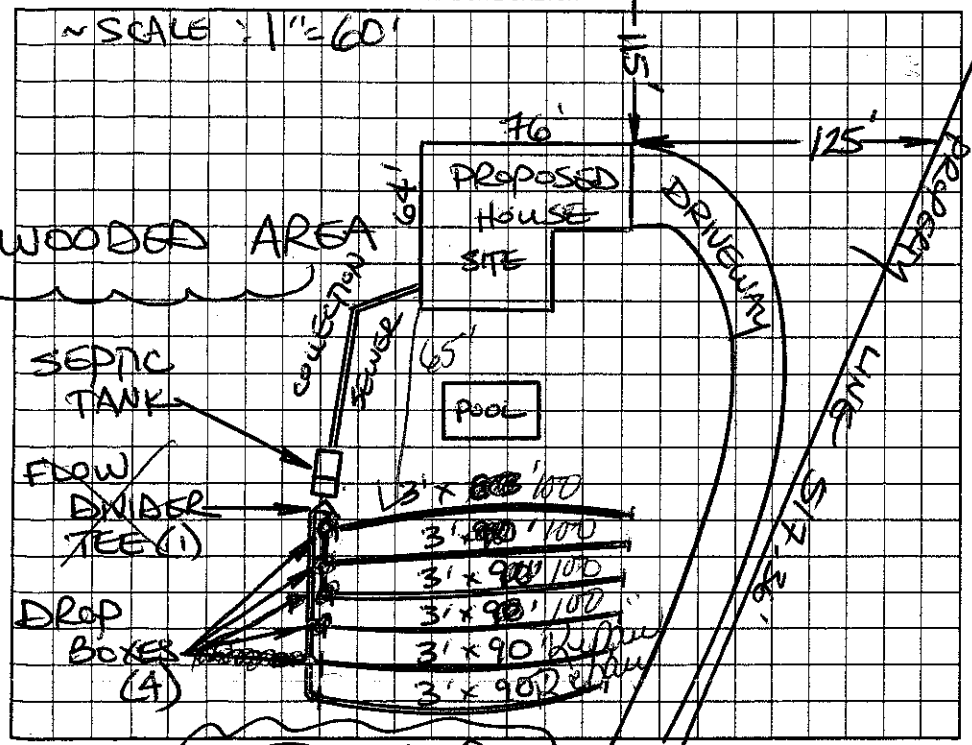

Comments/Conditions: Yellow Sub Sole Septictank Marks

AS BUILT SKETCH

Permit can be suspended or revoked if any false information is supplied toward securing the permit/any unauthorized changes are made to the site/any unauthorized changes are made in the installation of the system. Improvement Permit with plat valid without expiration. Improvement Permit with site plan valid for sixty months. Authorization to Construct is valid for a period equal to that of Improvement Permit – not to exceed sixty months.

Signed: [signature] date 11-19-04 Installed by: DAVID Yount

Improvement Permit by: STEVE HEDRICK date 11-19-04 Operation Permit by: [signature] date 9-8-06

Authorization to Construct by: STEVE HEDRICK date 11-19-04 Existing System Inspection by: ____ date ____

HEALTH DEPT. COPY: WHITE OWNER COPY (FINAL): YELLOW OWNER COPY (INITIAL): PINK