57065

IREDELL COUNTY HEALTH DEPARTMENT

STATESVILLE 704-878-5305 MOORESVILLE 704-664-5281

IMPROVEMENT PERMIT / CERTIFICATE OF COMPLETION / OPERATION PERMIT / EXISTING SYSTEM INSPECTION

PROPERTY DESCRIPTION NO. 17173 DATE 4-13-95 TAX MAP NO. 116-7-31 Watershed: ☐ Yes ☑ No

OWNER OR CONTRACTOR Cool Springs VFD PHONE: Business Home 873 6720

ADDRESS Mocksville Hwy

LOCATION 64E TL Fifth creek Rt 1500' Rt

SUBDIVISION BLOCK / SECTION LOT LOT AREA 2.50 acres SITE CLASS. PS DESIGN FLOW 250 GPD L.T.A.R. > 3

Septic Tank: 1000 Gallons; STB 794 Date 6-26-95

Pump Tank: Gallons; PT Date

Pump Make: Model Serial No.

Nitrification Field: No Fields 1 Square Feet 900 Linear Feet 300

No Lines 5 Trench Width 36" Max Trench Bottom Depth 36" Gravel Depth 12"

☑ New System ☐ Repair System Type: I, II, III, IV, V, VI

System Description: Conv. Gravity

Repair System Description:

Maintenance Agreement Required: ☐ Yes ☑ No

☐ House/Mod. Home No. Bedrooms

☐ Mobile Home No. Bathrooms

☐ Business No. Employees

☑ Other Fire Sub Station


☑ Slab ☐ Crawl Space ☐ Basement w/plumbing ☐ Basement wo/plumbing

Water Supply:
☐ Individual
☐ Community
☑ Public


Comments:

Comments:

INITIAL SITE SKETCH

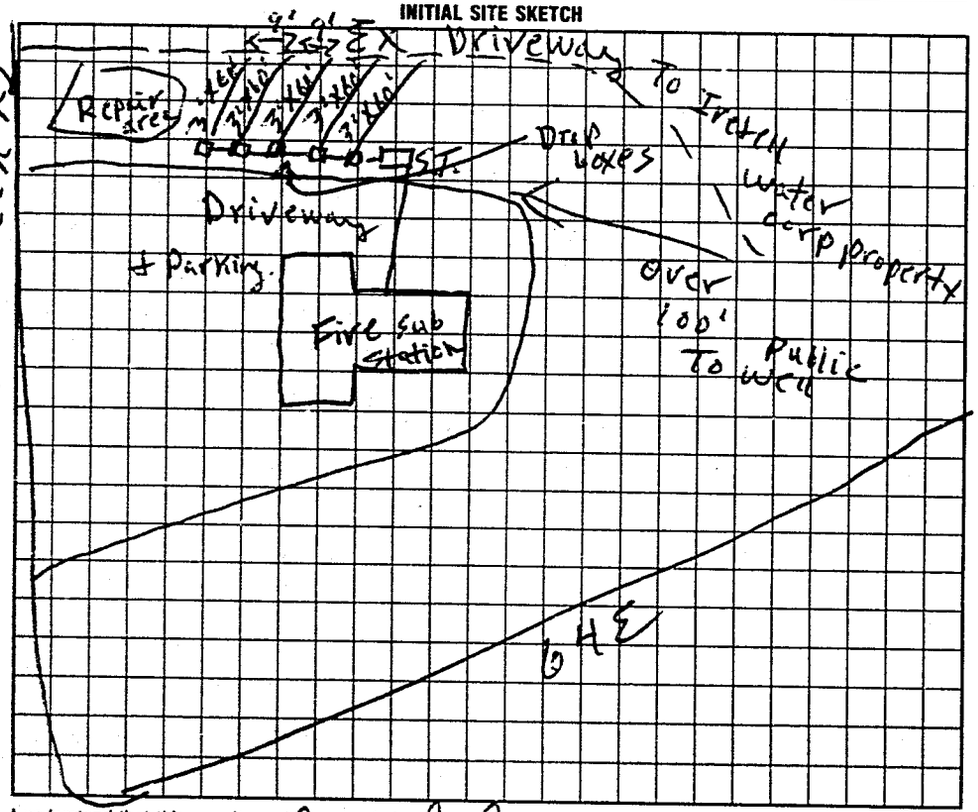

AS-BUILT SKETCH

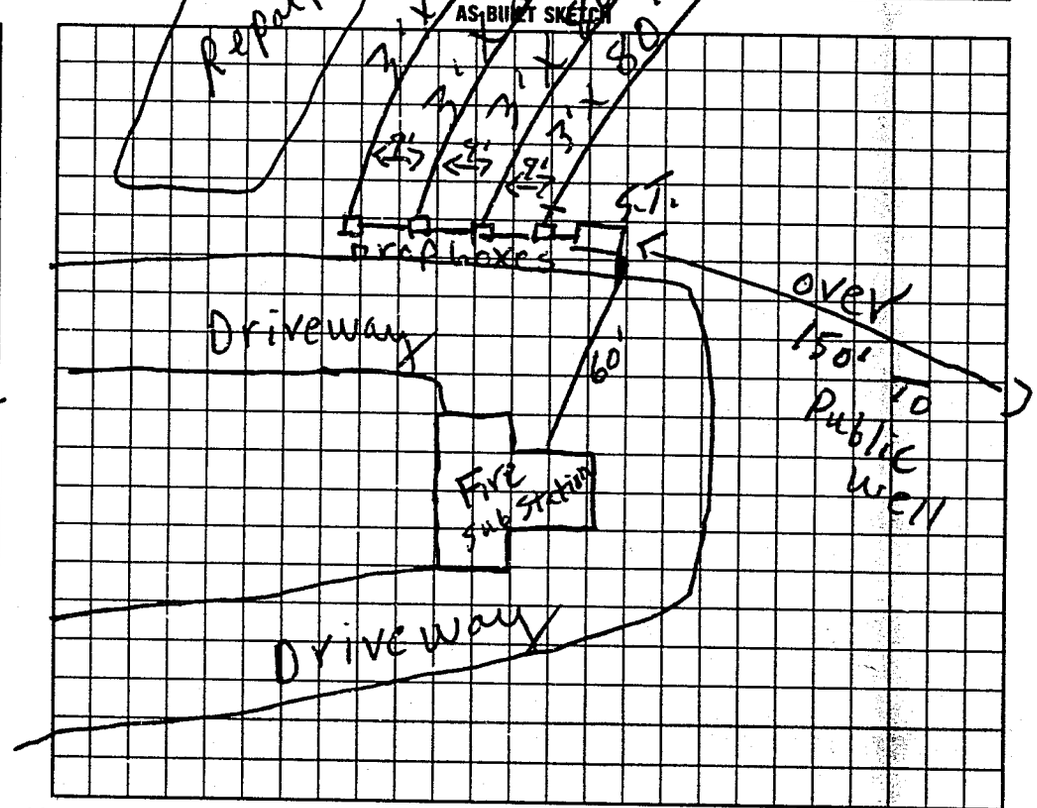

I understand that this permit can be suspended or revoked if any false information is supplied toward securing the permit/any unauthorized changes are made to the site/any unauthorized changes are made in the installation of the system. Improvement Permit is valid for 60 months from date of issuance.

Signed: X AGENT/ARCHITECT

Improvement Permit by: E. C. moore date 4-13-95

Existing System Inspection by: date

Installed by: James Hutler

Certificate of Completion by: E. C. moore date 9-28-95

Operation Permit by: date

HEALTH DEPT. COPY: WHITE INSPECTION COPY (FINAL): GREEN OWNER COPY (FINAL): YELLOW INSPECTION COPY (INITIAL): PINK OWNER COPY (INITIAL): GOLD