IREDELL COUNTY HEALTH DEPARTMENT

STATESVILLE 704-878-5305 (C1) MOORESVILLE 704-664-5281

IMPROVEMENT PERMIT / AUTHORIZATION TO CONSTRUCT / OPERATION PERMIT / EXISTING SYSTEM INSPECTION

(C1)

PERMIT# 115629 PIN# 4786-13-2963 DATE 9-19-03

OWNER OR CONTRACTOR HENRY HOWARD PHONE: Business 704-838-6116 Home 704-878-0299

ADDRESS 162 BLUEBERRY HILL DR, STATESVILLE, NC 28625

LOCATION US 64 EAST, TL FIFTH CREEK ROAD, TR GARRIS DRIVE, LOT ON LEFT AT BLUEBERRY HILL DRIVE

SUBDIVISION BLUEBERRY HILL EST. BLOCK / SECTION ____ LOT 25 & 26 LOT AREA 3.75 ACRES SITE CLASS. PS DESIGN FLOW 480 L.T.A.R. 0.30 GPD/FT²

Septic Tank: 1000 Gallons; STB 1007 Date 8-6-03
Pump Tank: ____ Gallons; PT ____ Date ____
Pump Make: ____ Model ____ Serial No. ____
Nitrification Field: No. Fields 1 Square Feet 1600' Linear Feet 535'
No. Lines FIVE Trench Width 36" Max Trench Bottom Depth 30" Gravel Depth 12"


☑ New System ☐ Repair System Type: I, (II), III, IV, V, VI
System Description: CONVENTIONAL, GRAVITY
Repair System Description: CONVENTIONAL, PUMP
Maintenance Agreement Required: ☐ Yes ☑ No

☑ House/Mod. Home No. Bedrooms 4
☐ Mobile Home No. Bathrooms 3
☐ Business No. Employees ____
☐ Other ____
☐ Slab ☐ Crawl Space ☑ Basement w/plumbing ☐ Basement wo/plumbing

Water Supply: ☐ Individual ☑ Public ☐ Community


Comments:/Conditions:
P.L. - 31'
CONTINUE CULVERT W/ SOLID PIPE THROUGH HEAD SLOPE & BACKFILL TO ACCOMODATE GRAVITY-FED COLLECTION SEWER.

INITIAL SITE SKETCH

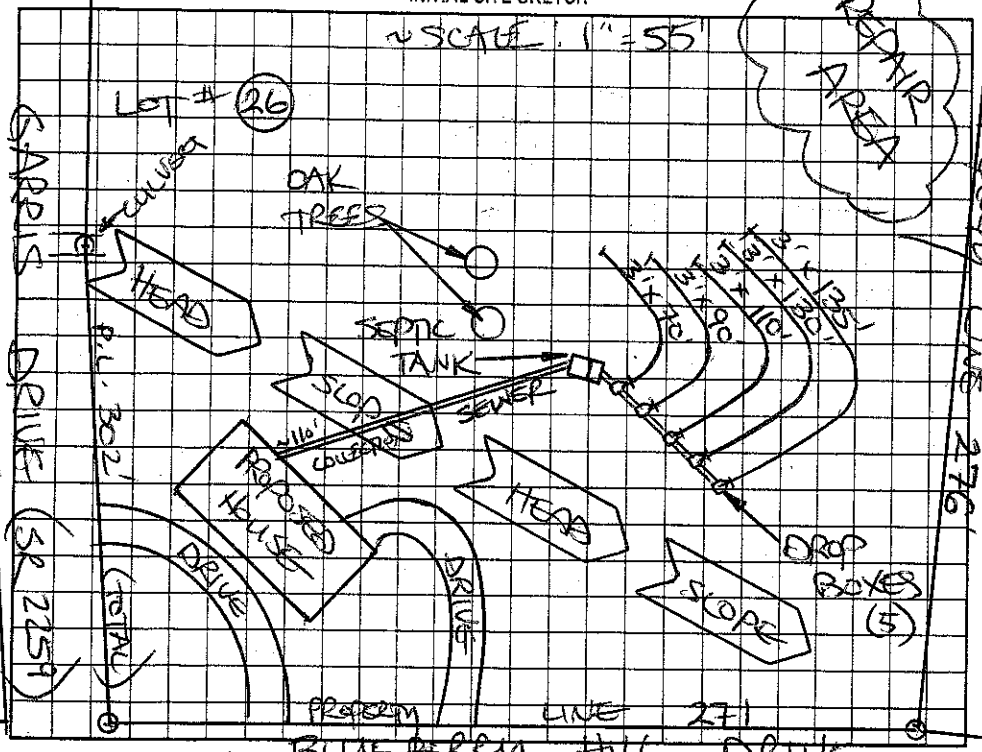

Comments:/Conditions: SEPTIC TANK WITH MARKER INSTALLED ACCORDING TO INITIAL SITE SKETCH USING "POLYLOK" FILTER. DISTRIBUTION ALTERED AS SHOWN WITH PRIOR HEALTH DEPT. APPROVAL

AS BUILT SKETCH

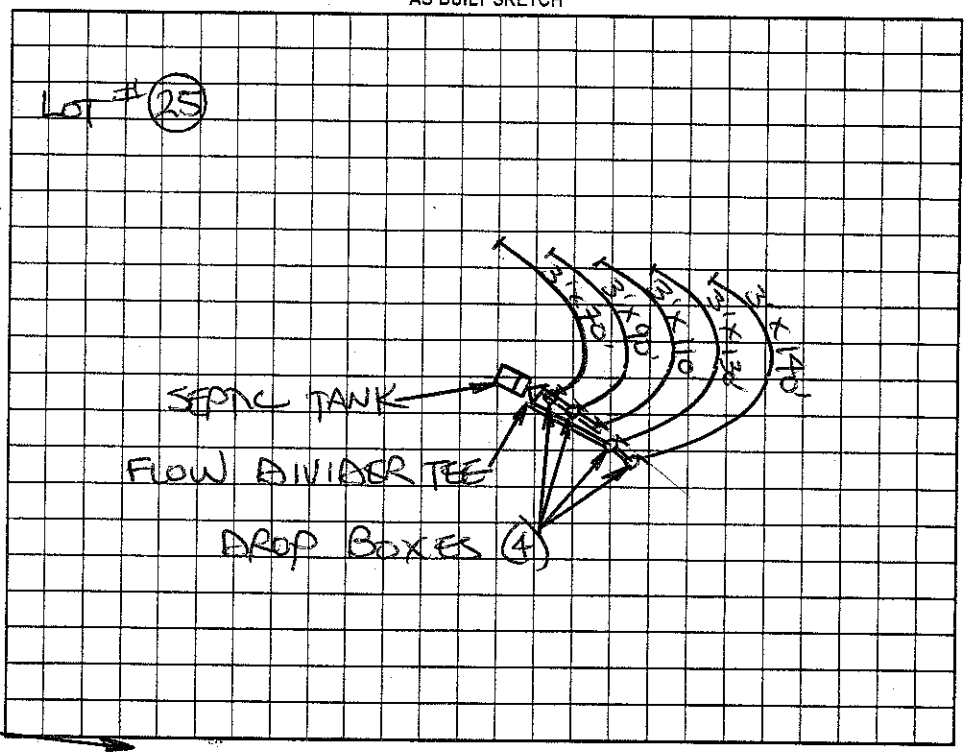

Permit can be suspended or revoked if any false information is supplied toward securing the permit/any unauthorized changes are made to the site/any unauthorized changes are made in the installation of the system. Improvement Permit with plat valid without expiration. Improvement Permit with site plan valid for sixty months. Authorization to Construct is valid for a period equal to that of Improvement Permit – not to exceed sixty months.

Signed: Henry K Howard date SEPT 19 03 Installed by: JAMES HUDLER

Improvement Permit by: STEVE HEDRICK date 9-19-03 Operation Permit by: STEVE HEDRICK date 9-26-03

Authorization to Construct by: STEVE HEDRICK date 9-26-03 Existing System Inspection by: ____ date ____

HEALTH DEPT. COPY: WHITE OWNER COPY (FINAL): YELLOW OWNER COPY (INITIAL): PINK