IREDELL COUNTY HEALTH DEPARTMENT

STATESVILLE 704-878-5305 MOORESVILLE 704-664-5281 52416

IMPROVEMENT PERMIT / CERTIFICATE OF COMPLETION / OPERATION PERMIT / EXISTING SYSTEM INSPECTION

PROPERTY DESCRIPTION NO. 18897 DATE 8-10-94 TAX MAP NO. 116-1-A-5 Watershed: ☐ Yes ☑ No

OWNER OR CONTRACTOR Susan Arcidiacono PHONE: Business Home 878 0299

ADDRESS 162 Blueberry Hill Dr. Sta

LOCATION 6.4 E Th Fifth creek Rd TR Garris Dr. TR Blueberry Hill Dr. 1ST lot rt

SUBDIVISION Blueberry Hills BLOCK / SECTION LOT 5 LOT AREA 2.24 acres SITE CLASS. PS DESIGN FLOW 360 L.T.A.R. .35

Septic Tank: 1000 Gallons; STB 794 Date 1-19-95

Pump Tank: Gallons; PT Date

Pump Make: Model 1200 Serial No. 402

Nitrification Field: No Fields 1 Square Feet 1035 Linear Feet 345

No Lines 3 Trench Width 36" Max Trench Bottom Depth 36" Gravel Depth 12"

☑ New System ☐ Repair System Type: I, II III, IV, V, VI

System Description: Conv. Gravity

Repair System Description: " "

Maintenance Agreement Required: ☐ Yes ☑ No

☑ House/Mod. Home No. Bedrooms 3

☐ Mobile Home No. Bathrooms 2½

☐ Business No. Employees

☑ Other


☐ Slab ☐ Crawl Space ☑ Basement w/plumbing ☐ Basement wo/plumbing

Water Supply: ☐ Individual ☐ Community ☑ Public

Comments:

Comments:

INITIAL SITE SKETCH

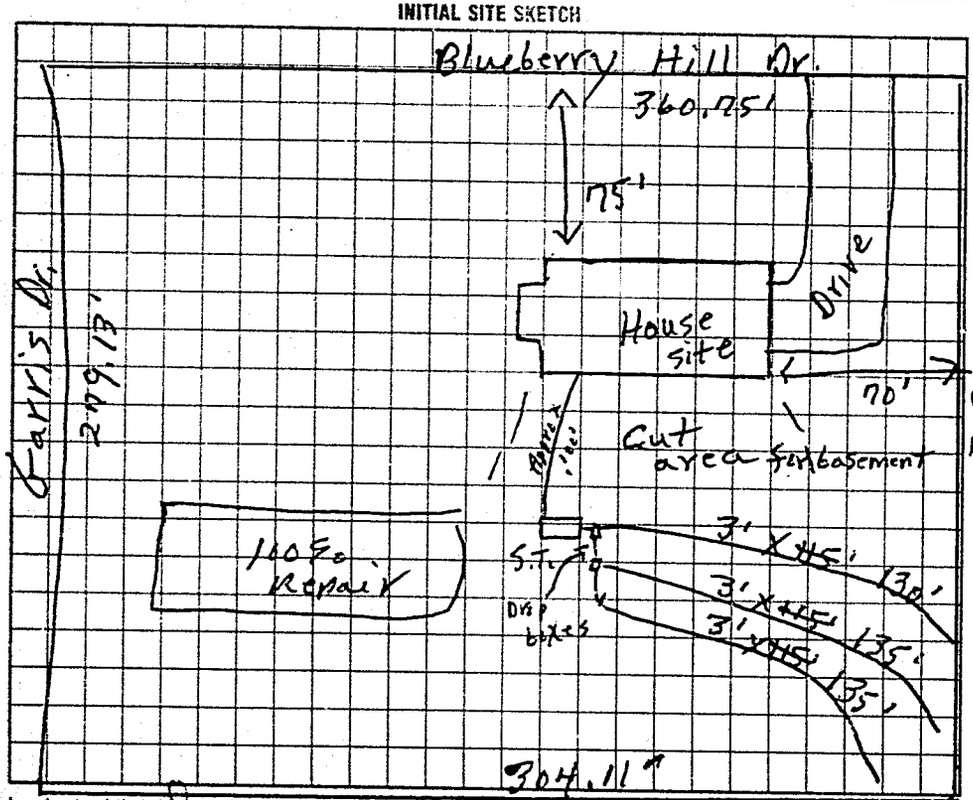

AS BUILT SKETCH

Same as initial sketch

I understand that this permit can be suspended or revoked if any false information is supplied toward securing the permit/any unauthorized changes are made to the site/any unauthorized changes are made in the installation of the system. Improvement Permit is valid for 60 months from date of issuance.

Signed: x Susan H Arcidiacono 9-10-94

Improvement Permit by: J.C. Moore date 8-10-94

Existing System Inspection by: date

Installed by: A-1 Backhoe

Certificate of Completion by: J-C. Moore date 3-23-95

Operation Permit by: date

HEALTH DEPT. COPY: WHITE INSPECTION COPY (FINAL) GREEN OWNER COPY (FINAL) YELLOW INSPECTION COPY (INITIAL) PINK OWNER COPY (INITIAL) GOLD