DELL COUNTY HEALTH DEPARTMENT

Statesville Office (704) 878-5305 Mooresville Office (704) 660-3625 PERMIT # 209475

...VEMENT PERMIT / AUTHORIZATION TO CONSTRUCT / OPERATION PERMIT / EXISTING SYSTEM

PIN # 4786137955

APPLICANT: Jan Elizabeth Hunter APPLICANT ADDRESS: 162 Blueberry Hill Dr Statesville NC

SITE ADDRESS: 162 Blueberry Hill Rd Statesville NC PHONE: 704-872-4310 ALT. PHONE: 704-437-0633

SITE DIRECTIONS: 64E T/L / 5th Creek T/R Garris T/R Blueberry Hill first drive on left.


SUBDIVISION: Blueberry Hill Estates SECTION: P1A LOT # 13A LOT AREA: 2.47ac DESIGN FLOW: 600 L.T.A.R.: 0.25

Septic Tank	Existing	(gal)	STB		Date		☐ New System ☐ Repair ☒ Expansion System Type: I II III IV V VI	☒ Residence	No. Bedrooms	5	Water Supply
Pump Tank		(gal)	PT		Date		System Description: 25% Reduction	☐ Business	No. Persons	10	☐ Private
Pump Make		Model			Serial #		Repair System Description: 50% Reduction	☐ Other	No. Employees		☒ Public
# Nitrification Fields	1	# Lines	2	Linear Ft:	240		Maintenance Agreement Required: ☐ YES ☒ NO	☐ Slab	☐ Crawl Space		☐ Community
Trench Width	36"	Max. Trench Bottom Depth	36"	Gravel Depth	N/A		☒ GRAVITY ☐ PRESSURE	☒ Basement w/plumbing			☐ Basement w/o plumbing


Comments / Conditions: Install 25% reduction on contour with serial distribution. Bring tank up to current standards with cement or approved risers. * minimum trench depth 36" high side *

The purpose of the permit is to increase home from 3 to 5 bedroom

INITIAL SITE SKETCH

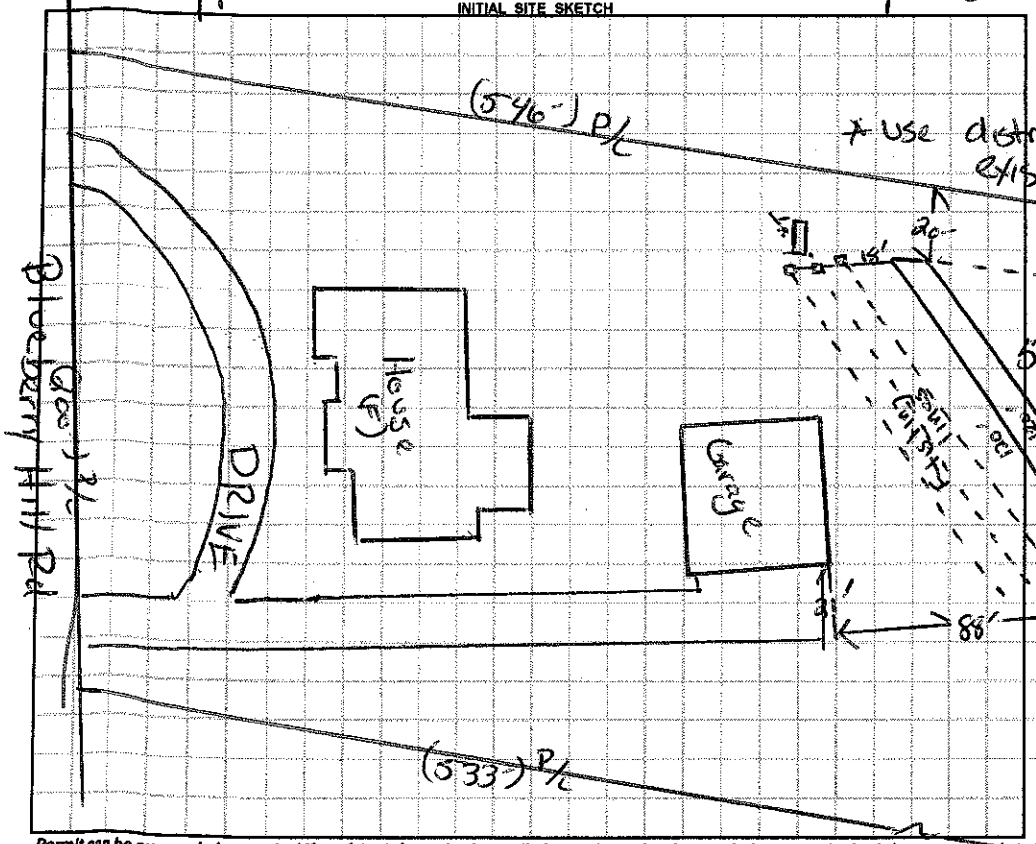

AS BUILT SKETCH

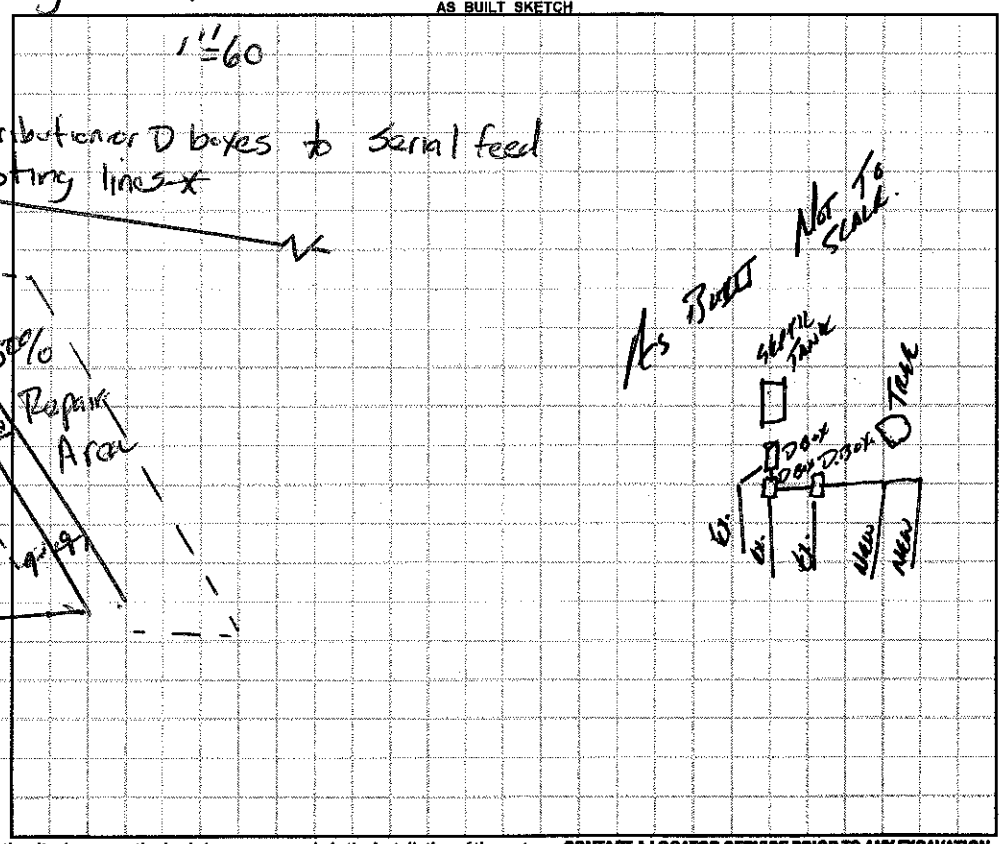

Permit can be suspended or revoked if any false information is supplied toward securing the permit / any unauthorized changes are made to the site / any unauthorized changes are made in the installation of the system. **CONTACT A LOCATOR SERVICE PRIOR TO ANY EXCAVATION**

☐ **IMPROVEMENT PERMIT** *with plat valid without expiration.* ☒ **IMPROVEMENT PERMIT** *with site plan valid for 60 mos.* ☒ **AUTHORIZATION TO CONSTRUCT** *valid for period equal to IMPROVEMENT PERMIT--not to exceed 60 mo.*

Owner / Applicant Signature: Jan Elizabeth Hunter Date: 6/5/15 Installed by: Younts Septic & Grading

IMPROVEMENT PERMIT by: David A Jones Date: 05/14/15 OPERATION PERMIT by: [signature] Date: 7/14/16

AUTHORIZATION TO CONSTRUCT by: David A Jones Date: 05/14/15 Existing System Inspected by: Date:

Health Dept. Copy - WHITE Applicant (Final Approval) - YELLOW Applicant (Conditional Approval) - PINK