IREDELL COUNTY HEALTH DEPARTMENT

Statesville Office (704) 878-5305 Mooresville Office (704) 660-3625 PERMIT # 21798

IMPROVEMENT PERMIT / AUTHORIZATION TO CONSTRUCT / OPERATION PERMIT / EXISTING SYSTEM

PIN # 4786138637

APPLICANT: Nelson Dellinger APPLICANT ADDRESS: 170 Pisgah Church Rd Statesville NC

SITE ADDRESS: 152 Blueberry Hill Rd Statesville NC PHONE: 704-902-0429 ALT. PHONE: 704-876-4387

SITE DIRECTIONS: 64E T/L Fifth Creek T/R Blueberry Hill Estates T/R Lot on Left

SUBDIVISION: Blueberry Hill Estates SECTION: ~~#~~ LOT # 12 LOT AREA: 3.87ac DESIGN FLOW: Ey L.T.A.R.: Ey

Septic Tank Ey (gal) STB Date

Pump Tank (gal) PT Date

Pump Make Model Serial #

Nitrification Fields Ey # Lines Ey Linear Ft: Ey

Trench Width Ey Max. Trench Bottom Depth Ey Gravel Depth Ey

☐ New System ☐ Repair ☐ Expansion System Type: I II III IV V VI

System Description: Existing

Repair System Description:

Maintenance Agreement Required: ☐ YES ☒ NO ☒ GRAVITY ☐ PRESSURE

☒ Residence No. Bedrooms 3

☐ Business No. Persons 6

☐ Other No. Employees


☐ Slab ☐ Crawl Space

☒ Basement w/plumbing ☐ Basement w/o plumbing


Water Supply
☐ Private
☒ Public
☐ Community

Comments / Conditions: Maintain 5' off any part of STS.

INITIAL SITE SKETCH

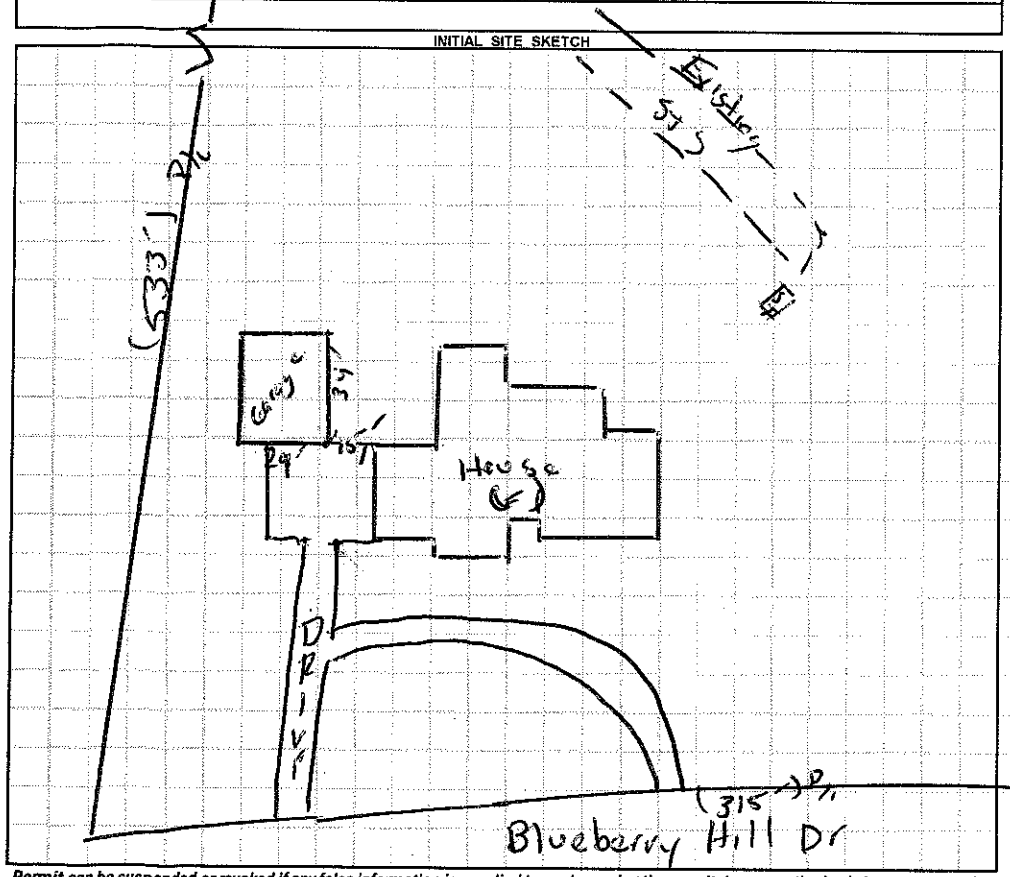

AS BUILT SKETCH

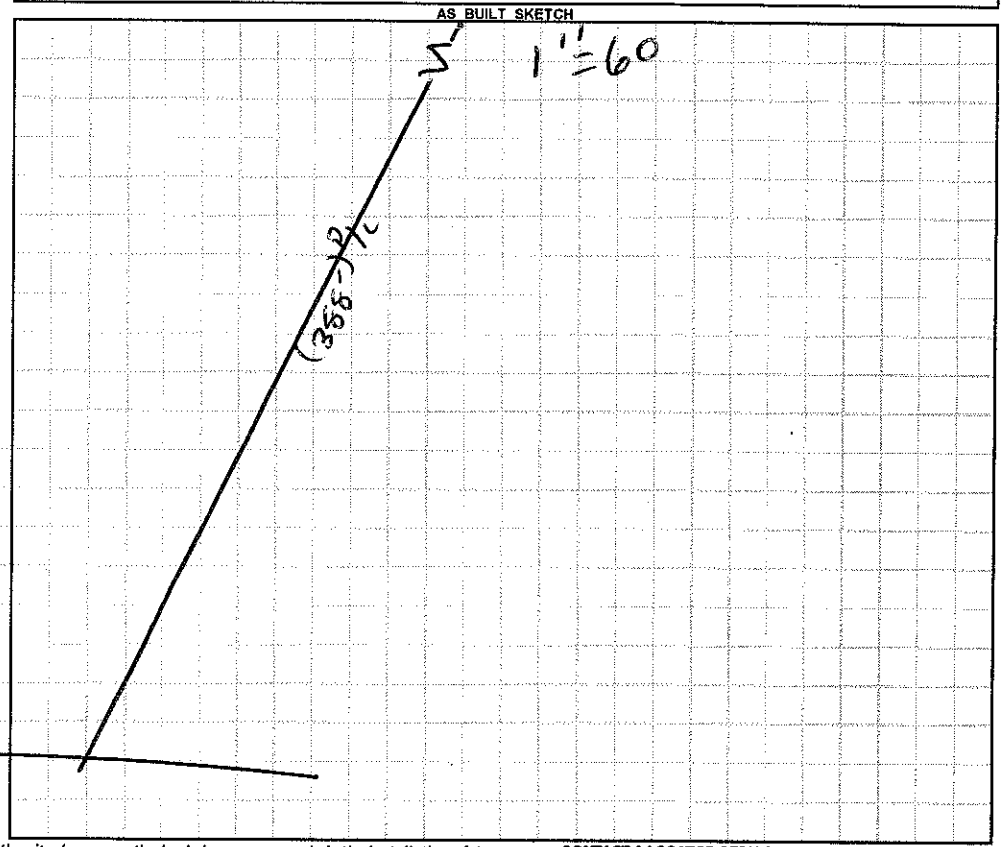

Permit can be suspended or revoked if any false information is supplied toward securing the permit / any unauthorized changes are made to the site / any unauthorized changes are made in the installation of the system. **CONTACT A LOCATOR SERVICE PRIOR TO ANY EXCAVATION**

☐ **IMPROVEMENT PERMIT** *with plat valid without expiration.* ☐ **IMPROVEMENT PERMIT** *with site plan valid for 60 mos.* ☐ **AUTHORIZATION TO CONSTRUCT** *valid for period equal to IMPROVEMENT PERMIT--not to exceed 60 mo.*

Owner / Applicant Signature: Date: 6-3-16 Installed by:

IMPROVEMENT PERMIT by: Date: OPERATION PERMIT by: Date:

AUTHORIZATION TO CONSTRUCT by: Date: Existing System Inspected by: Date: 06/01/16

Health Dept. Copy - WHITE Applicant (Final Approval) - YELLOW Applicant (Conditional Approval) - PINK