58823

IREDELL COUNTY HEALTH DEPARTMENT

STATESVILLE 704-878-5305 MOORESVILLE 704-664-5281

IMPROVEMENT PERMIT / CERTIFICATE OF COMPLETION / OPERATION PERMIT / EXISTING SYSTEM INSPECTION

PROPERTY DESCRIPTION NO. 22850 DATE 12-29-95 TAX MAP NO. 116-1-A-29 Watershed: ☐ Yes ☑ No

OWNER OR CONTRACTOR SHIVAPRASAD DHANAPAL PHONE: Business 875-9551, EXT 2213 Home 873-4207

ADDRESS 1003-7 FOXCROFT LN STVL, NC 28677

LOCATION US 64 E TL FIFTH CREEK RD, TR GARRIS, TL BLUEBERRY HILL DR, 3RD LOT ON LEFT

SUBDIVISION BLUEBERRY HILL BLOCK / SECTION LOT 29 LOT AREA 3.56 AC. SITE CLASS. PS DESIGN FLOW 360 L.T.A.R. 0.30 GPD/FT

Septic Tank: 1000 Gallons; STB 1012 Date 2-5-96

Pump Tank: Gallons; PT Date

Pump Make: Model Serial No.

Nitrification Field: No Fields 1 Square Feet 1200 Linear Feet 400

No Lines 4 Trench Width 36" Max Trench Bottom Depth 18-30" Gravel Depth 12"

☑ New System ☐ Repair System Type: I, ☑ III, IV, V, VI

System Description: CONVENTIONAL GRAVITY

Repair System Description: CONV. PUMP.

Maintenance Agreement Required: ☐ Yes ☑ No

☑ House/Mod. Home No. Bedrooms 3

☐ Mobile Home No. Bathrooms 3

☐ Business No. Employees

☐ Other


☐ Slab ☐ Crawl Space ☐ Basement w/plumbing ☑ Basement wo/plumbing

Water Supply: ☐ Individual ☐ Community ☑ Public


Comments: ① USE THREE FLOW DIVIDER TEES TO ACHIEVE EQUAL DISTRIBUTION INTO EACH OF FOUR 100' LINES. ② KEEP SYSTEM MINIMUM 50' FROM STREAM, 10' FROM WATER LINE

Comments:

INITIAL SITE SKETCH

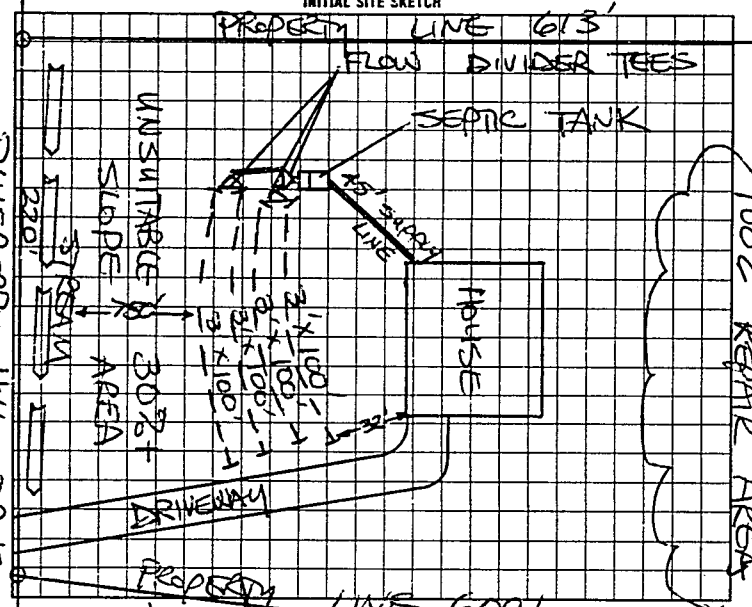

AS BUILT SKETCH

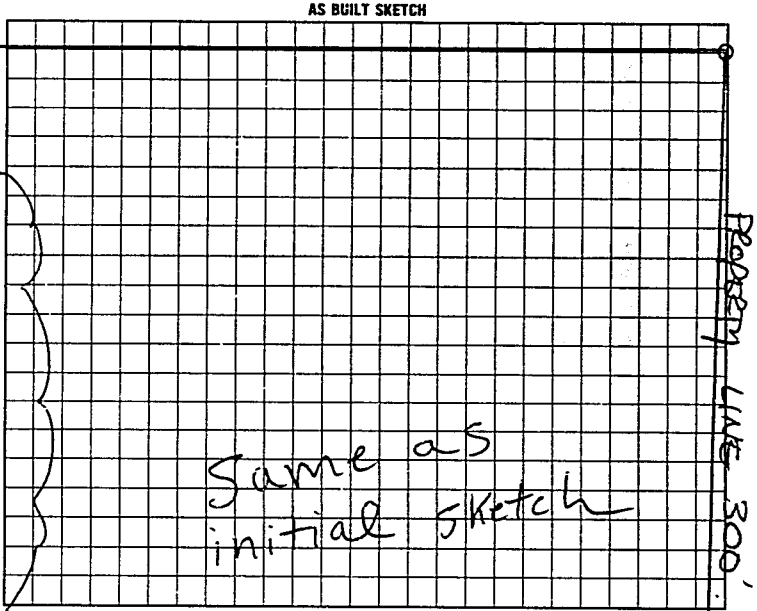

I understand that this permit can be suspended or revoked if any false information is supplied toward securing the permit, any unauthorized changes are made to the site/any unauthorized changes are made in the installation of the system.

AUTHORIZATION TO CONSTRUCT IS VALID FIVE (5) YEARS FROM DATE OF ISSUANCE. IMPROVEMENT PERMIT HAS NO EXPIRATION DATE.

Signed: X

Installed by: Ethic Yountz & Son

Improvement Permit by: STEVE HEDRICK date 12-29-95 Certificate of Completion by: date

AUTHORIZATION TO CONSTRUCT

Existing System Inspection by: STEVE HEDRICK date 12-29-95 Operation Permit by: P. C. Moore date 4-11-96

HEALTH DEPT. COPY: WHITE INSPECTION COPY (FINAL): GREEN OWNER COPY (FINAL): YELLOW INSPECTION COPY (INITIAL): PINK OWNER COPY (INITIAL): GOLD