IREDELL COUNTY HEALTH DEPARTMENT

STATESVILLE 704-878-5305 (C1) MOORESVILLE 704-664-5281

IMPROVEMENT PERMIT / AUTHORIZATION TO CONSTRUCT / OPERATION PERMIT / EXISTING SYSTEM INSPECTION

PERMIT# 112128 PIN# 4786-14-0688 DATE 08-12-03

OWNER OR CONTRACTOR KATHY VOGEL PHONE: Business Home 704-873-3598

ADDRESS 199 BLUEBERRY HILL DR. STATESVILLE, NC 28625

LOCATION 64E, (L) 5th CREEK, (R) GARRIS, (L) BLUEBERRY HILL, LOT #30 ON LEFT

SUBDIVISION BLUEBERRY HILL BLOCK / SECTION 2 LOT 30 LOT AREA 2.34 AC SITE CLASS. PS DESIGN FLOW 360 L.T.A.R. .35

Septic Tank: 1000 Gallons; STB 1007 Date 5-10-04

Pump Tank: _____ Gallons; PT _____ Date _____

Pump Make: _____ Model _____ Serial No. _____

Nitrification Field: No Fields 1 Square Feet 1028 Linear Feet 342'

No Lines 6X57' Trench Width 36" Max Trench Bottom Depth 36" Gravel Depth 10"

[X] New System [ ] Repair System Type: I, (II), III, IV, V, VI

System Description: GRAV CONV

Repair System Description: PUMP / LP 25% REDUCT

Maintenance Agreement Required: [ ] Yes [X] No

[X] House/Mod. Home No. Bedrooms 3

[ ] Mobile Home No. Bathrooms 3

[ ] Business No. Employees ____

[ ] Other _____

[ ] Slab [X] Crawl Space [ ] Basement w/plumbing [ ] Basement wo/plumbing


Water Supply: [ ] Individual [X] Public [ ] Community

Comments/Conditions: (1) INSTALL 6 LINES, 57' LONG, USING A FLOW DIVIDER TEE + 4 DROP BOXES. (2) INSTALL LINES ON CONTOURS. (3) MAINTAIN SETBACKS (4) CALL PRIOR TO INSTALLATION FOR FLAGOUT IF NECESSARY.


Comments/Conditions: THIS PERMIT REPLACES PREVIOUSLY ISSUED PERMIT DATED 5-22-03. @ SEPTIC TANK WITH MARKER INSTALLED USING RED "POLYLOK" FILTER

"NOT TO SCALE"

INITIAL SITE SKETCH

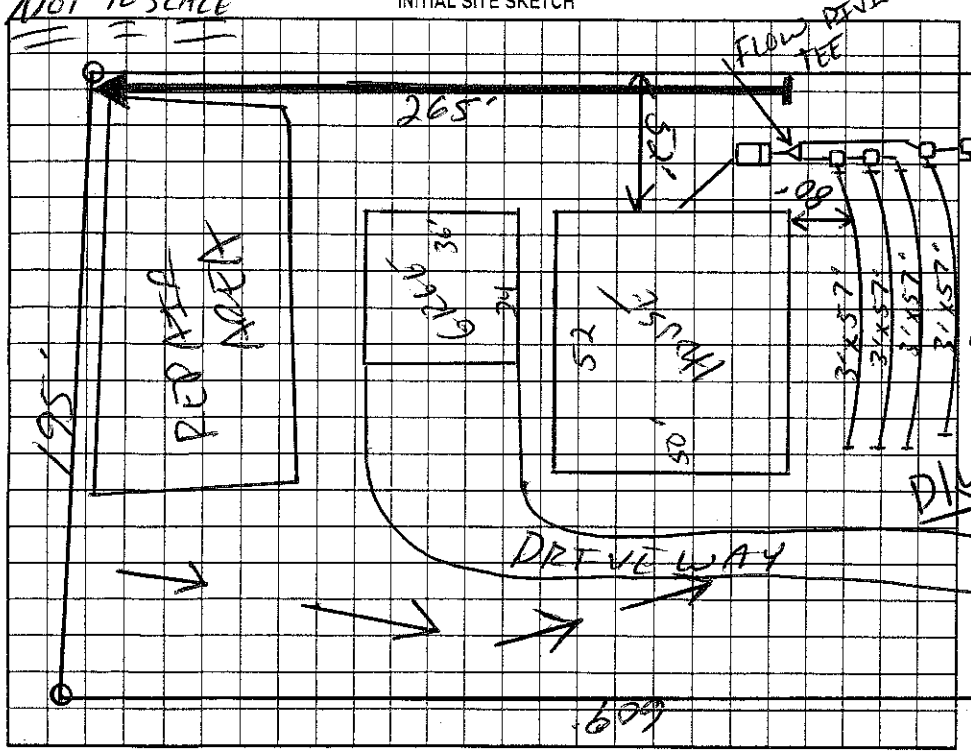

AS BUILT SKETCH

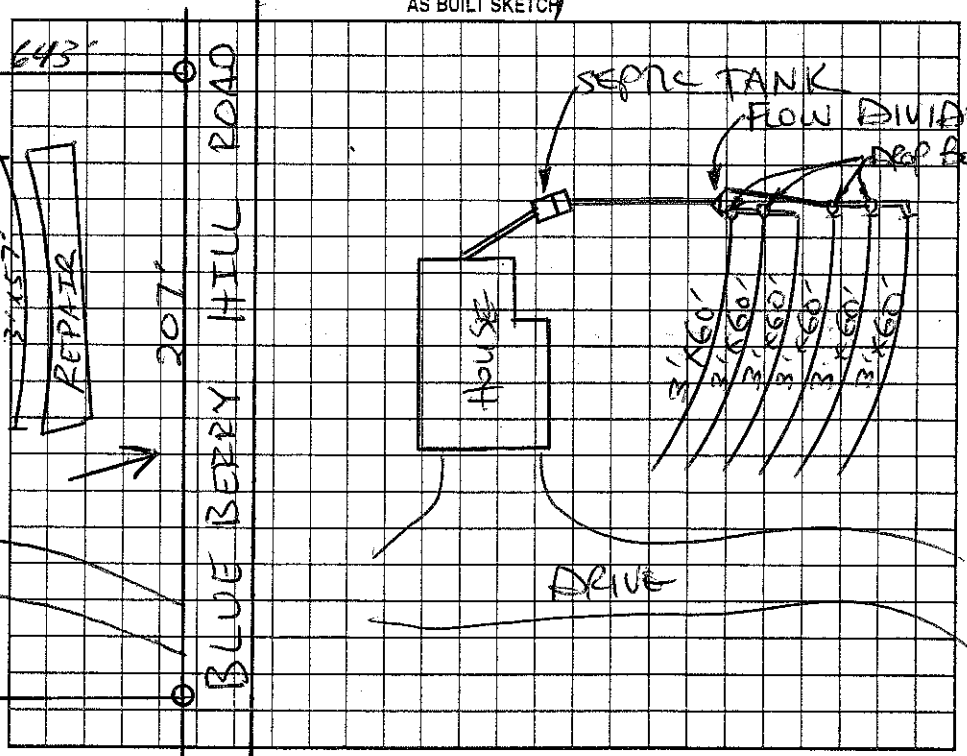

Permit can be suspended or revoked if any false information is supplied toward securing the permit/any unauthorized changes are made to the site/any unauthorized changes are made in the installation of the system. Improvement Permit with plat valid without expiration. Improvement Permit with site plan valid for sixty months. Authorization to Construct is valid for a period equal to that of Improvement Permit – not to exceed sixty months.

Signed: _____ date 8-18-03 Installed by: JAMES HADLER

Improvement Permit by: _____ date 8-12-03 Operation Permit by: STEVE HENDRICK date 7-16-09

Authorization to Construct by: _____ date 8-12-03 Existing System Inspection by: _____ date _____

HEALTH DEPT. COPY: WHITE OWNER COPY (FINAL): YELLOW OWNER COPY (INITIAL): PINK