IREDELL COUNTY HEALTH DEPARTMENT

STATESVILLE 704-878-5305 (C) MOORESVILLE 704-664-5281

IMPROVEMENT PERMIT / AUTHORIZATION TO CONSTRUCT / OPERATION PERMIT / EXISTING SYSTEM INSPECTION

PERMIT# 108454 PIN# 4786-15-1276 DATE 09-18-02

OWNER OR CONTRACTOR KATHY VOGEL PHONE: Business Home 704-873-3598

ADDRESS 1274 FOURTH CREEK LANDING DR. STATESVILLE NC 28625

LOCATION 64 E, (1) 5TH CREEK RD. (12) GARRIS, AT END TURN LEFT, LOT # 33 ON LEFT

SUBDIVISION BLUEBERRY HILLS BLOCK / SECTION 2 LOT 33 LOT AREA 3.38 AC SITE CLASS PS DESIGN FLOW 480 L.T.A.R. .3

Septic Tank: 1000 Gallons; STB 794 Date 7-12-03
Pump Tank: 1000 Gallons; PT 27 Date 7-13-03
Pump Make: Model Serial No.
Nitrification Field: No Fields 1 Square Feet 1600' Linear Feet 533'
No Lines 4X133' Trench Width 36" Max Trench Bottom Depth 36" Gravel Depth 12"

[X] New System [ ] Repair System Type: I, II, (III) IV, V, VI
System Description: PUMP CONV
Repair System Description: SAME
Maintenance Agreement Required: [ ] Yes [X] No

[X] House/Mod. Home [ ] Mobile Home [ ] Business [ ] Other
No. Bedrooms 4 No. Bathrooms 4.5 No. Employees


[ ] Slab [ ] Crawl Space [X] Basement w/plumbing [ ] Basement wo/plumbing

Water Supply: [ ] Individual [X] Public [ ] Community


Comments/Conditions: (1) CALL PRIOR TO INSTALLATION FOR PUMP SIZING & FLAGOUT (2) MAINTAIN SETBACK (3) TANKS WILL NEED TO BE PRESSURE/LEAK TESTED (4) FOLLOW PROPER CREEK CROSSING RULES (5) MAINTAIN

Comments/Conditions: BASEMENT FOUNDATION DRAIN SETBACKS, 25' UPSLOPE, 15' SIDESLOPE, 10' DOWNSLOPE
(1) UPPER THREE LINES & TANKS INSPECTED 8-18-03 RSH
(2) LOWER LINE & PRESSURE CHECK OK 8-20-03 RSH

INITIAL SITE SKETCH "NOT TO SCALE"

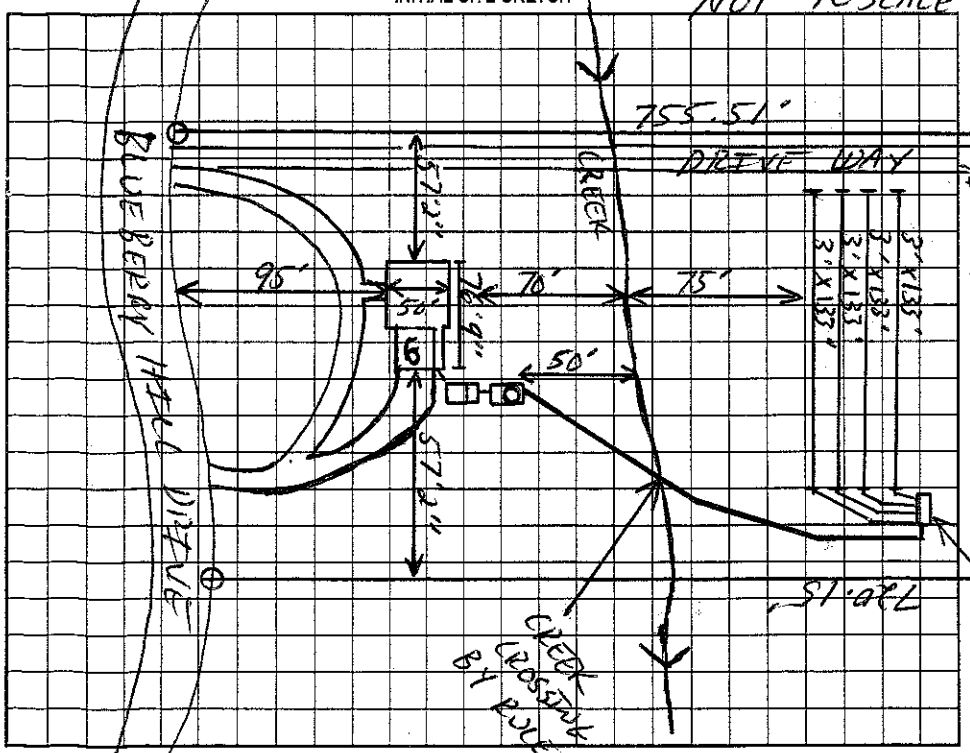

AS BUILT SKETCH

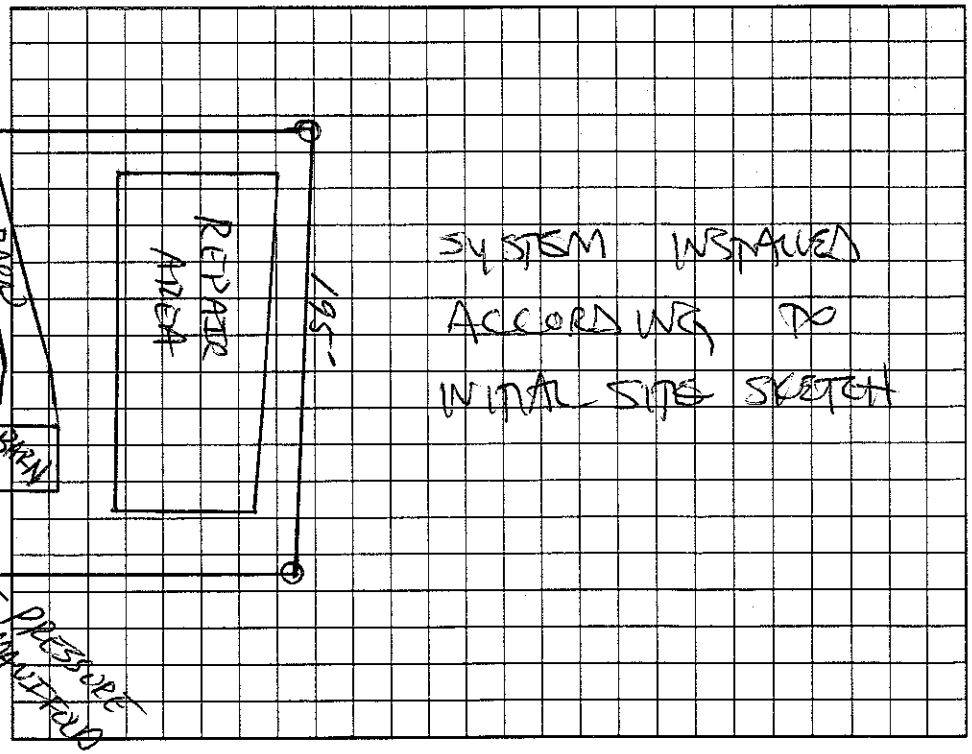

Permit can be suspended or revoked if any false information is supplied toward securing the permit/any unauthorized changes are made to the site/any unauthorized changes are made in the installation of the system. Improvement Permit with plat valid without expiration. Improvement Permit with site plan valid for sixty months. Authorization to Construct is valid for a period equal to that of Improvement Permit – not to exceed sixty months.

Signed: Kathy Vogel date 9-19-02 Installed by: JAMES HAGER

Improvement Permit by: date 09/19/02 Operation Permit by: STEVE HEARICK date 12-12-03

Authorization to Construct by: date 09-19-02 Existing System Inspection by: date

HEALTH DEPT. COPY: WHITE OWNER COPY (FINAL): YELLOW OWNER COPY (INITIAL): PINK