IREDELL COUNTY HEALTH DEPARTMENT

STATESVILLE 704-878-5305 MOORESVILLE 704-664-5281

IMPROVEMENT PERMIT / AUTHORIZATION TO CONSTRUCT / OPERATION PERMIT / EXISTING SYSTEM INSPECTION

PERMIT # REPAIR PIN # 4786-22-3597 DATE APRIL 30, 2009

OWNER or APPLICANT MARY E. SETTLE PHONE: Business Home: 704-873-0973

OWNER or APPLICANT ADDRESS 1642 MOCKSVILLE Hwy, CLEVELAND NC 27013

LOCATION / DIRECTIONS US 64 EAST, ON RIGHT AT BOX #1642 JUST PAST FIFTH CREEK ROAD

SUBDIVISION BLOCK / SECTION LOT # LOT AREA 0.83 AC DESIGN FLOW 360 L.T.A.R. 0.30 GPD/FT2

Septic Tank EXISTING Gallons: STB Date

Pump Tank Gallons: P T Date

Pump Make Model Serial #

Nitrification Field No Fields 1 No Lines 2 Linear Feet 160

Trench Width 36" Max. Trench Bottom Depth 36" Gravel Depth N/A

☐ New System ☑ Repair ☐ Expansion System Type I II (III) IV V VI

System Description:

Repair System Description: 25% REDUCTION, GRAVITY

Maintenance Agreement Required ☐ YES ☑ NO

☑ GRAVITY ☐ PRESSURE


☑ Residence No. Bedrooms 2 (3) ☐ Business No. Persons ☐ Other No. Employees ☐ Slab ☐ Crawl Space ☐ Basement w/plumbing ☐ Basement w/o plumbing

Water Supply ☐ Private ☑ Public ☐ Community

Comments / Conditions INSTALL NEW 25% REDUCTION SYSTEM AS FLAGGED.

Comments / Conditions NEW SANITREM TEE INSTALLED IN SEPTIC TANK

INITIAL SITE SKETCH

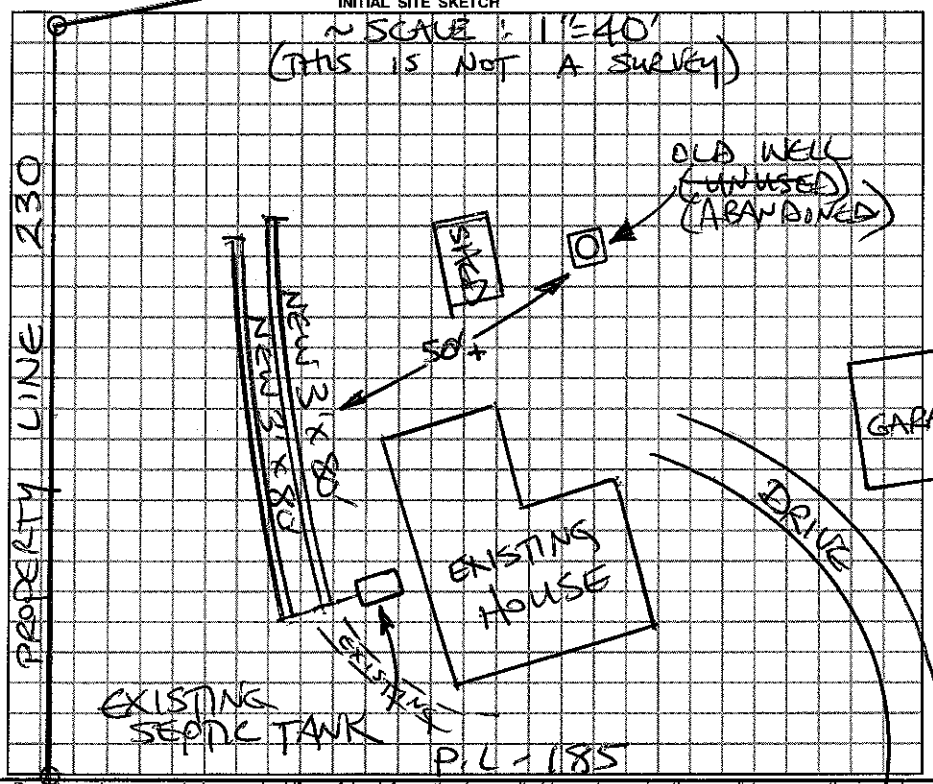

AS BUILT SKETCH

SYSTEM REPAIRED ACCORDING TO INITIAL SITE SKETCH

Permit can be suspended or revoked if any false information is supplied toward securing the permit / any unauthorized changes are made to the site / any unauthorized changes are made in the installation of the system.

☐ *IMPROVEMENT PERMIT w / plat valid without expiration.* ☑ *IMPROVEMENT PERMIT w / site plan valid for 60 mos.* ☐ *AUTHORIZATION TO CONSTRUCT valid for period equal to IMPROVEMENT PERMIT-not to exceed 60 mo.*

Owner / Applicant Signature: Mary E. (Jean) Settle Date 4-30-09

Improvement Permit by: STEVE HEDRICK Date 4-30-09

Authorization to Construct by: STEVE HEDRICK Date 4-30-09

Installed by: A-1 BACKHOE

Operation Permit by: STEVE HEDRICK Date: 5-1-09

Existing System Inspected by: Date:

YOU SHOULD CONTACT A LOCATOR SERVICE PRIOR TO ANY EXCAVATION.

WHITE COPY Environmental Health YELLOW COPY (Final) Owner / Applicant PINK COPY (Initial) Owner / Applicant